


CA MUTCD 2026 Figure Markups (Draft)

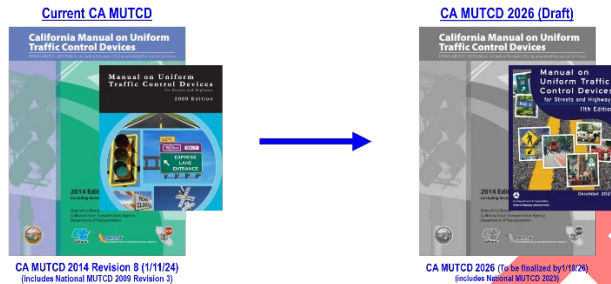

The National MUTCD 2023 is published by Federal Highway Administration's (FHWA) under 23 Code of Federal Regulations (CFR), Part 655, Subpart F. On December 19, 2023, a Final Rule adopting the National MUTCD 2023 was published in the Federal Register with an effective date of January 18, 2024. States must adopt the National MUTCD as their legal State standard for traffic control devices within two years from the effective date.

Caltrans began the process to review National MUTCD 2023 for adoption in California by soliciting CA MUTCD practitioners statewide to form 10 Subject Matter Expert (SME) Workgroups based on the individual Parts of the MUTCD. Each SME Workgroup conducted weekly/bi-weekly review meetings to discuss changes in the National MUTCD 2023 and compare them with current California MUTCD 2014 Revision 8 to assess potential impacts of adopting these changes in California. SME Workgroup members provided comments and recommendations to Caltrans, to assist with the development of these initial draft documents. Caltrans is preparing the initial draft version of CA MUTCD 2026 to revise California MUTCD 2014 Revision 8 (current) to be in substantial conformance with FHWA's National MUTCD 2023 (11th Edition). Initial draft chapters of CA MUTCD 2026, as they are completed, are being posted on the webpage and open to public for review and providing comments.

This "Figure Comparisons" document has been prepared by Caltrans to share the changes that are reflected in CA MUTCD 2026 initial draft version figures, when compared to National MUTCD 2023 figures, as well as current CA MUTCD 2014 Revision 8 figures (which were based on National MUTCD 2009). This document identifies California specific figures that are incorporated into CA MUTCD 2026 initial draft version and figures that are not incorporated and provides brief explanation, if they aren't incorporated. This document is being provided for ease in comparison, when reviewing CA MUTCD 2026 initial draft.

Though every effort has been made by Caltrans to ensure accuracy of this document, the inherent variances between National MUTCD and California MUTCD, along with moving of contents and reorganization undertaken by FHWA in the National MUTCD 2023, there may be unintentional errors or omissions in this document or some contents may have been overlooked.

Reference documents and information related to California's National MUTCD 2023 review and adoption efforts is available at the following websites:

- National MUTCD 2023 - <https://mutcd.fhwa.dot.gov/>
- California MUTCD 2014 Revision 8 - <https://dot.ca.gov/programs/safety-programs/camutcd>
- National MUTCD 2023 review (including CA MUTCD 2026 Drafts) - <https://dot.ca.gov/programs/safety-programs/camutcd/nmutcd>

Figure changes reflected in CA MUTCD 2026 initial draft version, when compared to current CA MUTCD 2014 Revision 8 and National MUTCD 2023, are provided as follows:




- **Blue text, "X" and/or blue rectangle**  - Revisions to National MUTCD 2009 Figures in current CA MUTCD 2014 Revision 8 that continue to be applicable to National MUTCD 2023 Figures, are being retained and shown with markups with text comments added for explanation.
- **Green text and/or green rectangle**  and **Yellow highlighted text** - Changes in National MUTCD 2023 Figures, when compared to current CA MUTCD 2014 Revision 8 Figures (which were based on National MUTCD 2009) are shown with markups and text comments are added for explanation.
- **Red text, black text with red strikethrough, "X" and/or red rectangle**  - New changes that are being proposed for the National MUTCD 2023 figures or current CA MUTCD 2014 Revision 8 figures are shown with markups and text comments are added for explanation. These changes are new, some of them are needed due to the changes in National MUTCD 2023, while others are based on current SME Workgroup member reviews and recommendations to improve CA MUTCD.

Figure 7B-1. Signs in School Areas and at School Crossings (Sheet 1 of 2)

1 – School area signs

School Advance Crossing Assembly D(CA) 5

School Crossing Assembly B(CA) 7

School Zone Sign Assembly A(CA) 11

School Speed Limit Assembly C(CA) 6

School Speed Limit When Flashing Sign 4

OR 10



S1-1



S1-1



S1-1



W16-9P



W16-7P



SW24-3(CA)



W16-2aP



W16-2P



W16-5P (optional)



W16-6P (optional)



SW24-2(CA)



W16-5P (optional)



W16-6P (optional)



SW24-1(CA)



S4-7P (optional)



S4-3P (optional)




S4-3P

OR


R2-1



S4-2P

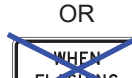

S4-4P

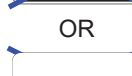

S4-1P



S4-6P



S5-1

R2-6P (optional)



SR4-1(CA)

* If used, the assembly or sign with WHEN FLASHING legend shall be accompanied by a flashing yellow Speed Limit Sign Beacon (see Section 4S.04).



S3-1




S3-2



S4-5



S4-5a

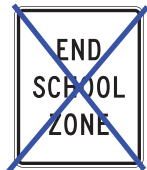

S5-2



S5-3

























R2-10



R2-11

Summary of Comments on CAMUTCD 2026 7B Fig.pdf

Page: 1

	Number: 1	Author: s116730	Subject: Highlight	Date: 7/25/2024 9:46:00 AM
NMUTCD 2023 changed the title of Figure 7B-1 from "School Area Signs" to "Signs in School Areas and at School Crossings" and incorporated signs from NMUTCD 2009 Figures 7B-1 and 7B-6 and added sub-headings A thru D, expanding Figure 7B-1 into 2 sheets.				
NMUTCD 2023 added sign codes for all signs, which were missing in NMUTCD 2009 figures				
	Number: 2	Author: s116730	Subject: Highlight	Date: 7/25/2024 9:46:06 AM
NMUTCD 2023 added sub-heading A				
	Number: 3	Author: s116730	Subject: Cross-Out	Date: 7/8/2024 11:11:18 AM
	Number: 4	Author: s116730	Subject: Highlight	Date: 7/25/2024 9:46:13 AM
NMUTCD 2023 added new text				
	Number: 5	Author: s116730	Subject: Text Box	Date: 7/9/2024 3:32:56 PM
D(CA)				
	Number: 6	Author: s116730	Subject: Text Box	Date: 7/9/2024 4:02:20 PM
C(CA)				
	Number: 7	Author: s116730	Subject: Text Box	Date: 7/9/2024 3:33:04 PM
B(CA)				
	Number: 8	Author: s116730	Subject: Line	Date: 7/8/2024 11:10:57 AM
	Number: 9	Author: s116730	Subject: Line	Date: 7/8/2024 11:11:04 AM
	Number: 10	Author: s116730	Subject: Text Box	Date: 7/9/2024 4:04:35 PM
OR				
	Number: 11	Author: s116730	Subject: Text Box	Date: 7/9/2024 4:13:49 PM
Assembly A(CA)				
	Number: 12	Author: s116730	Subject: Rectangle	Date: 7/9/2024 4:03:24 PM
Add SR4-1(CA) image in Assembly C(CA) between the R2-1 and S4-1P				
	Number: 13	Author: s116730	Subject: Line	Date: 7/9/2024 4:06:01 PM
	Number: 14	Author: s116730	Subject: Line	Date: 7/8/2024 10:52:49 AM
	Number: 15	Author: s116730	Subject: Line	Date: 7/8/2024 10:53:42 AM
	Number: 16	Author: s116730	Subject: Line	Date: 7/8/2024 10:57:59 AM
	Number: 17	Author: s116730	Subject: Line	Date: 7/8/2024 10:57:59 AM
	Number: 18	Author: s116730	Subject: Text Box	Date: 7/9/2024 3:56:43 PM
OR				
	Number: 19	Author: s116730	Subject: Line	Date: 7/9/2024 4:08:27 PM
	Number: 20	Author: s116730	Subject: Rectangle	Date: 7/9/2024 3:56:19 PM
Add SW24-3(CA) image in Assembly D(CA) between the W16-9P and W16-2aP				
	Number: 21	Author: s116730	Subject: Line	Date: 7/8/2024 11:12:25 AM
	Number: 22	Author: s116730	Subject: Line	Date: 7/8/2024 11:12:17 AM

Comments from page 1 continued on next page

Figure 7B-1. Signs in School Areas and at School Crossings (Sheet 1 of 2)

A – School area signs


School Advance Crossing Assembly D(CA)

School Crossing Assembly B(CA)

School Zone Sign Assembly A(CA)

School Speed Limit Assembly C(CA)

~~School Speed Limit When Flashing Sign~~

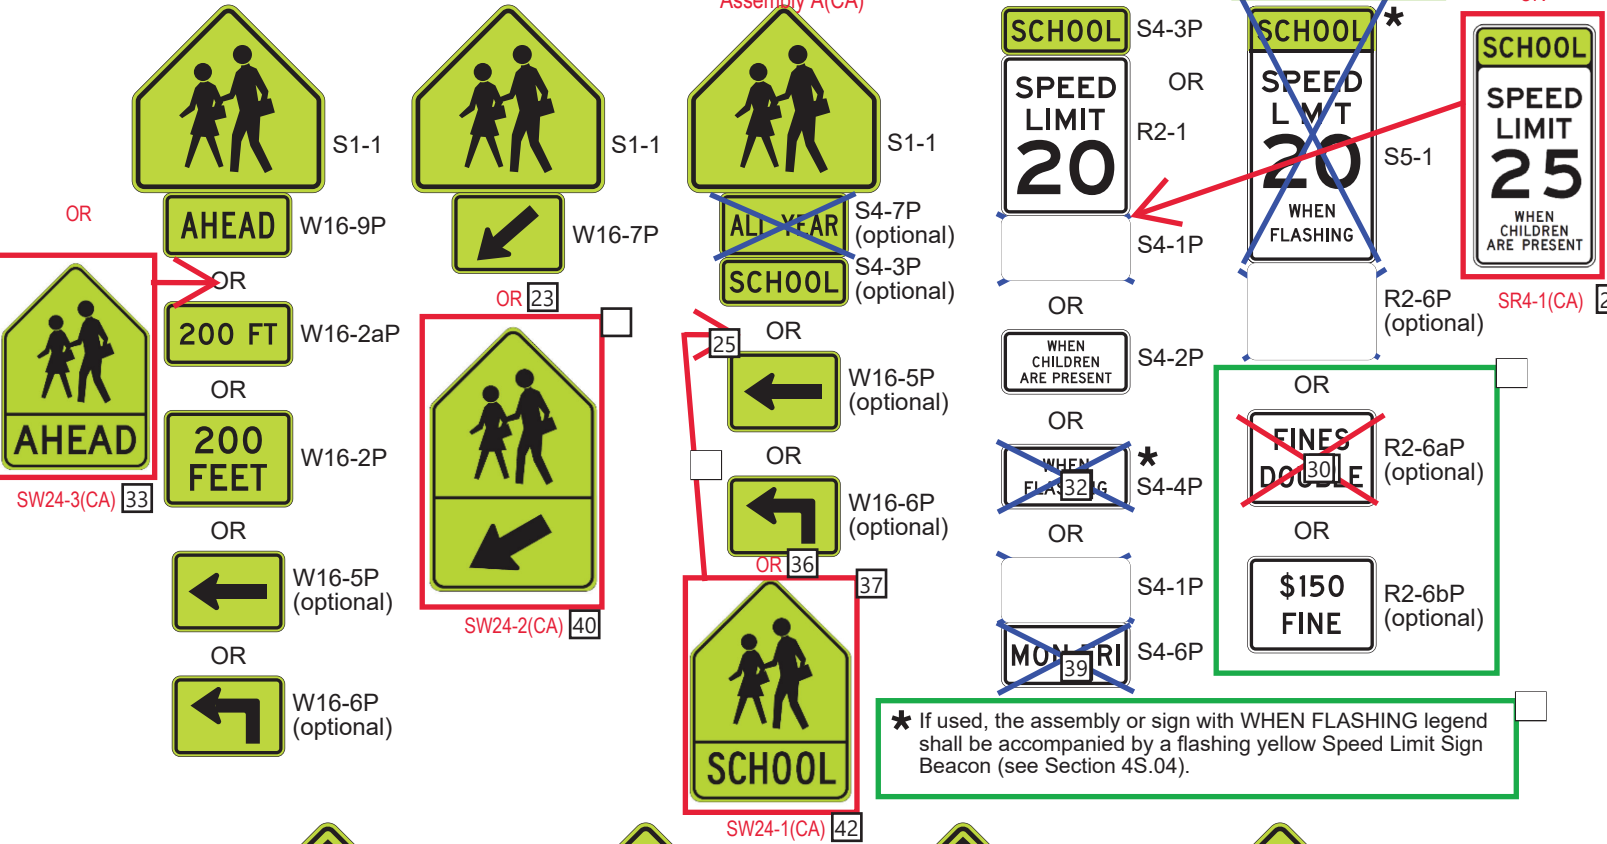

S3-1




S3-2



S4-5



S4-5a

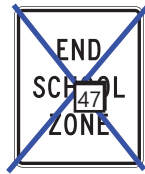

S5-2



S5-3



R2-10



R2-11

	Number: 23	Author: s116730	Subject: Text Box	Date: 7/9/2024 3:57:09 PM
				OR
	Number: 24	Author: s116730	Subject: Text Box	Date: 7/9/2024 4:04:01 PM
				SR4-1(CA)
	Number: 25	Author: s116730	Subject: Line	Date: 7/9/2024 4:07:36 PM
	Number: 26	Author: s116730	Subject: Rectangle	Date: 7/9/2024 3:59:42 PM
	Add SW24-2(CA) image in Assembly D(CA) below the W16-7P			
	Number: 27	Author: s116730	Subject: Line	Date: 7/9/2024 4:06:50 PM
	Number: 28	Author: s116730	Subject: Rectangle	Date: 7/13/2024 10:03:54 AM
	NMUTCD 2023 added new signs			
	Number: 29	Author: s116730	Subject: Line	Date: 7/8/2024 11:16:39 AM
	Number: 30	Author: s116730	Subject: Line	Date: 7/8/2024 11:16:39 AM
	Number: 31	Author: s116730	Subject: Line	Date: 7/8/2024 10:57:28 AM
	Number: 32	Author: s116730	Subject: Line	Date: 7/8/2024 10:57:13 AM
	Number: 33	Author: s116730	Subject: Text Box	Date: 7/9/2024 3:56:26 PM
				SW24-3(CA)
	Number: 34	Author: s116730	Subject: Line	Date: 7/8/2024 10:58:34 AM
	Number: 35	Author: s116730	Subject: Line	Date: 7/8/2024 10:58:34 AM
	Number: 36	Author: s116730	Subject: Text Box	Date: 7/9/2024 3:57:52 PM
				OR
	Number: 37	Author: s116730	Subject: Rectangle	Date: 7/9/2024 3:47:20 PM
	Add SW24-1(CA) image in Assembly A(CA) between the S4-3P and W16-5P			
	Number: 38	Author: s116730	Subject: Line	Date: 7/8/2024 10:58:51 AM
	Number: 39	Author: s116730	Subject: Line	Date: 7/8/2024 10:58:51 AM
	Number: 40	Author: s116730	Subject: Text Box	Date: 7/9/2024 3:58:56 PM
				SW24-2(CA)
	Number: 41	Author: s116730	Subject: Rectangle	Date: 7/13/2024 10:04:44 AM
	NMUTCD 2023 added new note			
	Number: 42	Author: s116730	Subject: Text Box	Date: 7/9/2024 3:57:21 PM
				SW24-1(CA)
	Number: 43	Author: s116730	Subject: Line	Date: 7/8/2024 11:13:52 AM
	Number: 44	Author: s116730	Subject: Line	Date: 7/8/2024 11:13:18 AM
	Number: 45	Author: s116730	Subject: Line	Date: 7/8/2024 11:13:52 AM
	Number: 46	Author: s116730	Subject: Line	Date: 7/8/2024 11:14:21 AM
	Number: 47	Author: s116730	Subject: Line	Date: 7/8/2024 11:13:30 AM
	Number: 48	Author: s116730	Subject: Line	Date: 7/8/2024 11:14:21 AM

Comments from page 1 continued on next page

Figure 7B-1. Signs in School Areas and at School Crossings (Sheet 1 of 2)

A – School area signs

School Advance Crossing Assembly D(CA)






School Crossing Assembly B(CA)

School Zone Sign Assembly A(CA)

School Speed Limit Assembly C(CA)

~~School Speed Limit When Flashing Sign~~


OR

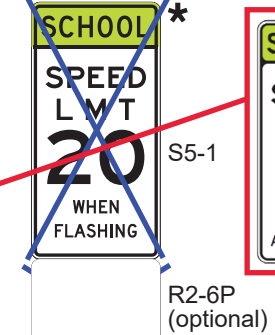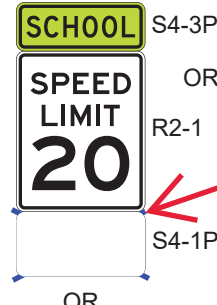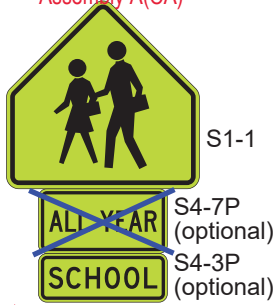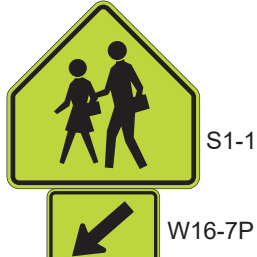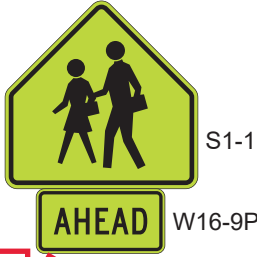

OR



SW24-2(CA)

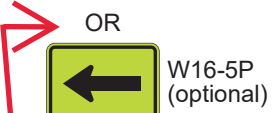

SW24-1(CA)



* If used, the assembly or sign with WHEN FLASHING legend shall be accompanied by a flashing yellow Speed Limit Sign Beacon (see Section 4S.04).



S3-1




S3-2



S4-5



S4-5a

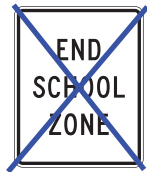

S5-2



S5-3




R2-10




R2-11

Figure 7B-1. Signs in School Areas and at School Crossings ¹ (Sheet 2 of 2)


2 – Signs in advance of the school crossing

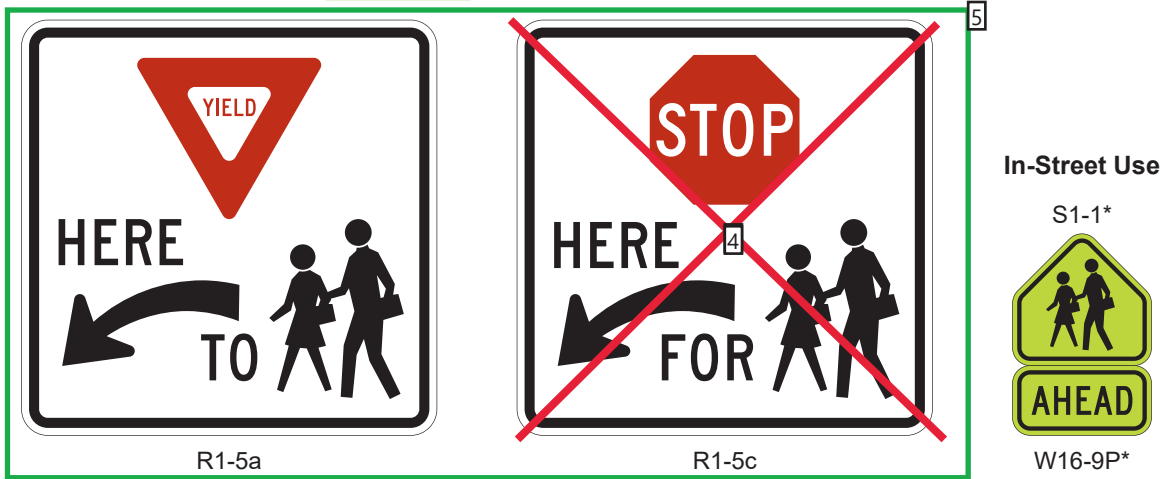

6 – In-street signs at the school crossing

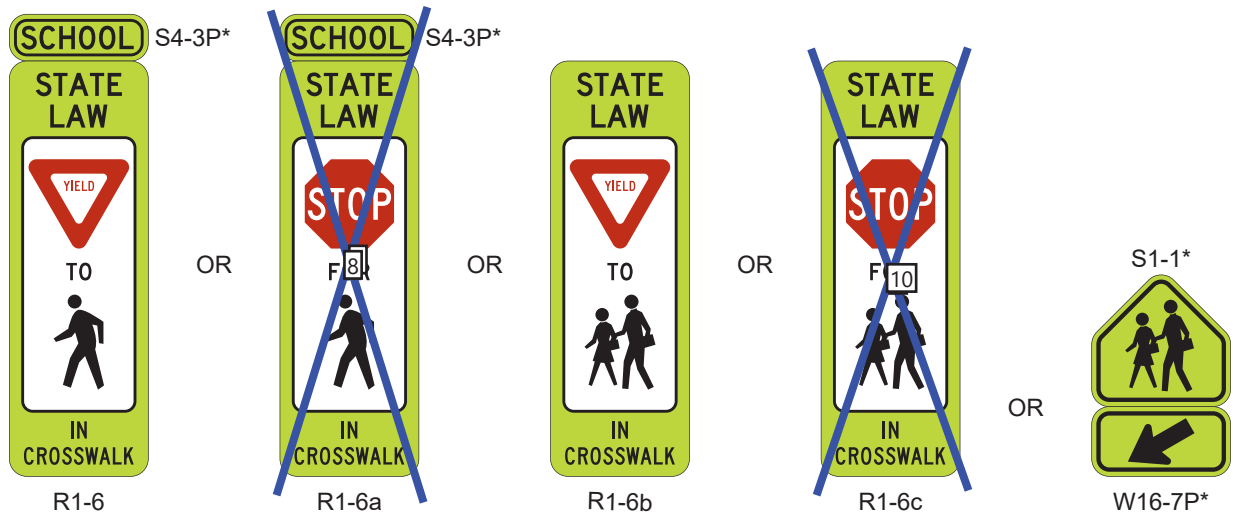

11 – Overhead signs at the school crossing ^{Assembly E(CA)} ¹²

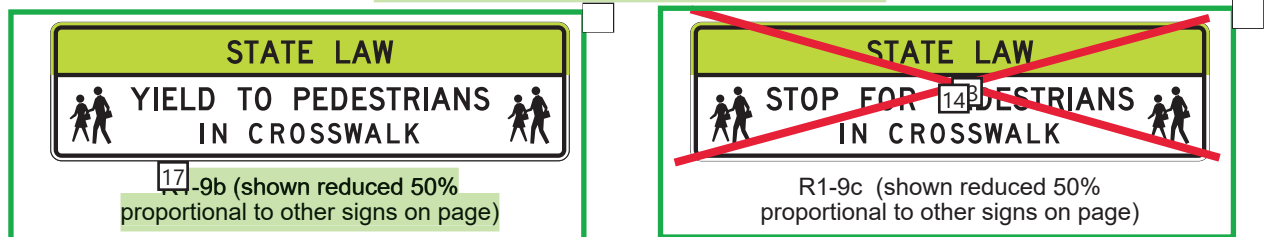

Notes:


1. The use of the STATE LAW legend is optional on the R1-6 series ¹⁹ and R1-9 series signs (see Section 7B.03).
2. The use of the SCHOOL plaque above the R1-6 and R1-6a signs is optional.
3. ²⁰ Signs are shown in proportion to their designated sizes unless otherwise noted.

*Reduced size signs ¹⁸ in-street use (see Section 7B.03):

S1-1	12 x 12 inches
S4-3P	12 x 4 inches
W16-7P	12 x 6 inches
W16-9P	12 x 6 inches


-
- Number: 1 Author: s116730 Subject: Highlight Date: 7/25/2024 9:46:47 AM
NMUTCD 2023 changed the title of Figure 7B-1 from "School Area Signs" to "Signs in School Areas and at School Crossings" and incorporated signs from NMUTCD 2009 Figures 7B-1 and 7B-6 and added sub-headings A thru D, expanding Figure 7B-1 into 2 sheets.
- NMUTCD 2023 added sign codes for all signs, which were missing in NMUTCD 2009 figures
-
- Number: 2 Author: s116730 Subject: Highlight Date: 7/25/2024 9:46:51 AM
NMUTCD 2023 changed sub-heading A in NMUTCD 2009 Figure 7B-6 to B
-
- Number: 3 Author: s116730 Subject: Line Date: 7/10/2024 8:44:02 AM
-
- Number: 4 Author: s116730 Subject: Line Date: 7/10/2024 8:44:02 AM
-
- Number: 5 Author: s116730 Subject: Rectangle Date: 7/13/2024 10:07:09 AM
NMUTCD 2023 added new signs
-
- Number: 6 Author: s116730 Subject: Highlight Date: 7/25/2024 9:47:03 AM
NMUTCD 2023 changed sub-heading B in NMUTCD 2009 Figure 7B-6 to C
-
- Number: 7 Author: s116730 Subject: Line Date: 7/14/2024 8:17:45 AM
-
- Number: 8 Author: s116730 Subject: Line Date: 7/14/2024 8:17:45 AM
-
- Number: 9 Author: s116730 Subject: Line Date: 7/14/2024 8:17:45 AM
-
- Number: 10 Author: s116730 Subject: Line Date: 7/14/2024 8:17:45 AM
-
- Number: 11 Author: s116730 Subject: Highlight Date: 7/25/2024 9:47:07 AM
NMUTCD 2023 added sub-heading D
-
- Number: 12 Author: s116730 Subject: Text Box Date: 7/9/2024 4:12:53 PM
Assembly E(CA)
-
- Number: 13 Author: s116730 Subject: Line Date: 7/10/2024 8:46:35 AM
-
- Number: 14 Author: s116730 Subject: Line Date: 7/10/2024 8:46:24 AM
-
- Number: 15 Author: s116730 Subject: Rectangle Date: 7/13/2024 10:07:36 AM
NMUTCD 2023 added new signs
-
- Number: 16 Author: s116730 Subject: Rectangle Date: 7/13/2024 10:07:27 AM
NMUTCD 2023 added text "IN CROSSWALK" as 3rd line in the sign
-
- Number: 17 Author: s116730 Subject: Highlight Date: 7/25/2024 9:47:24 AM
NMUTCD 2023 changed sign code from R1-9 in NMUTCD 2009 to R1-9b and added this text description.
-
- Number: 18 Author: s116730 Subject: Highlight Date: 7/25/2024 9:47:33 AM
-
- Number: 19 Author: s116730 Subject: Highlight Date: 7/25/2024 9:47:28 AM
NMUTCD 2023 added this text in the Note #1. Note #1 previously was in NMUTCD 2009 Figure 7B-6.
-
- Number: 20 Author: s116730 Subject: Highlight Date: 7/25/2024 9:47:38 AM
NMUTCD 2023 added new note

Figure 7B-1(CA). Signs in School Areas and at School Crossings

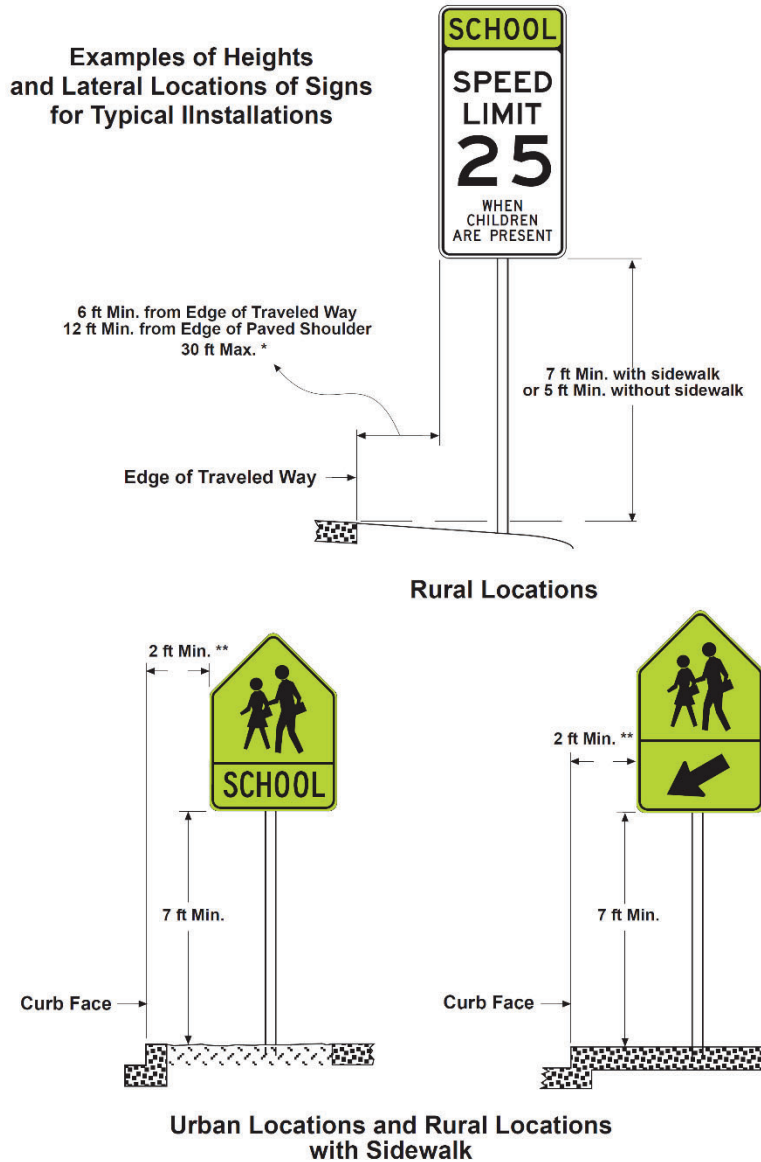



NOTES:

- (*) When clear roadside recovery areas are provided, signs shall be placed as far from the edge of traveled way as possible, up to a maximum of 30 ft. When possible they shall be placed in locations less likely to be hit by a vehicle leaving the traveled way. Signs should not be closer than 6 ft from the edge of a paved shoulder, or if none, 12 ft from the edge of the traveled way.
- (**) In urban areas, where sidewalk width is limited or existing poles are close to the curb, a clearance of 1 ft from the curb face is permissible.

 Number: 1 Author: s116730 Subject: Sticky Note Date: 7/16/2024 7:58:04 AM
Figure name changed to match NMUTCD 2023 Figure 7B-1 name and text for "(Sheet 2 of 2)" is deleted.

This figure is included in CA MUTCD 2026.

 Number: 2 Author: s116730 Subject: Cross-Out Date: 7/10/2024 8:41:50 AM

 Number: 3 Author: s116730 Subject: Cross-Out Date: 7/25/2024 9:48:03 AM
NMUTCD 2023 changed the title of Figure 7B-1 from "School Area Signs" to "Signs in School Areas and at School Crossings"


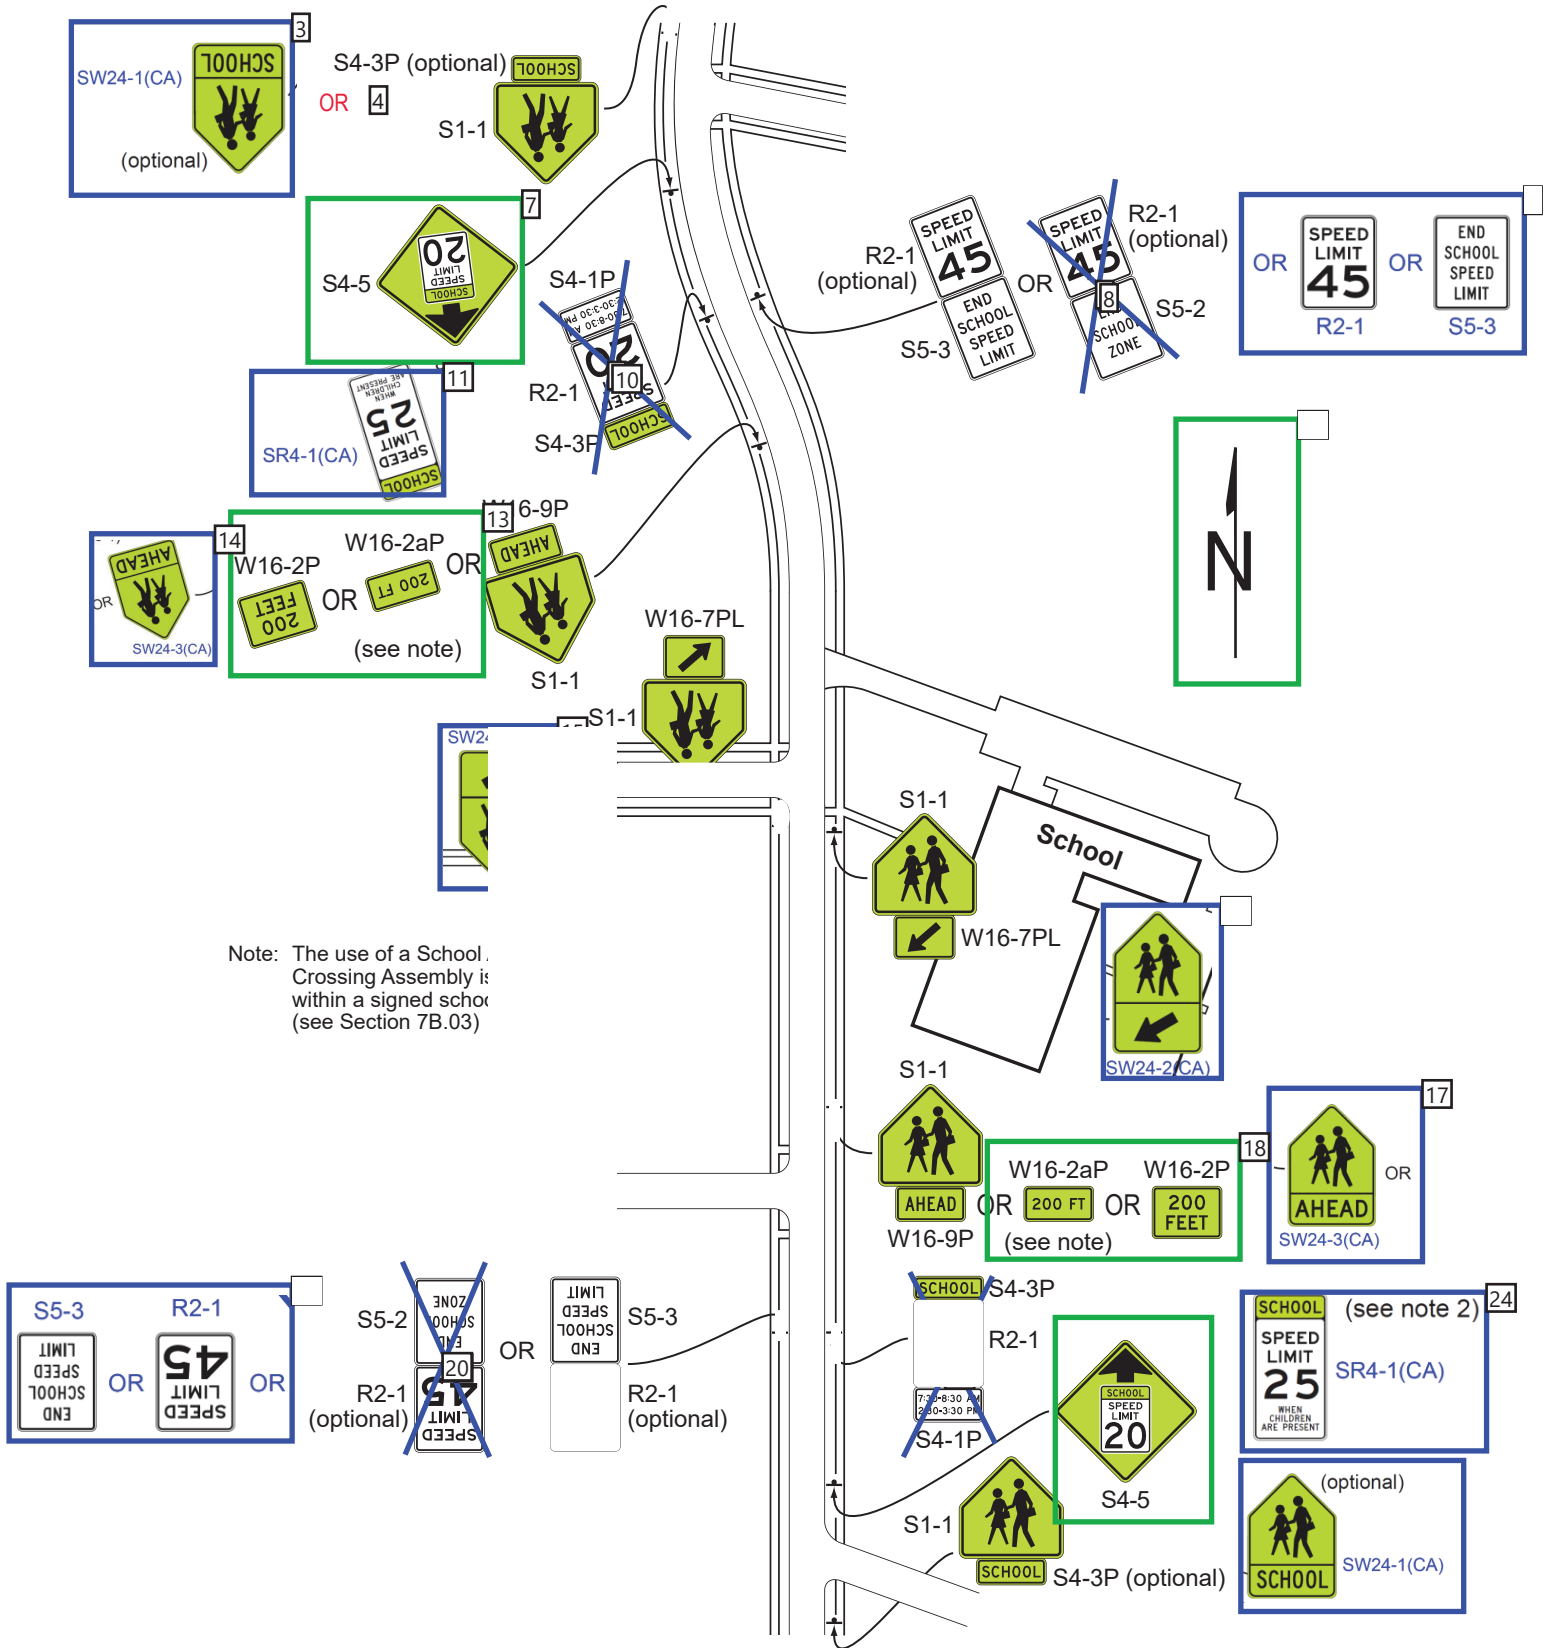
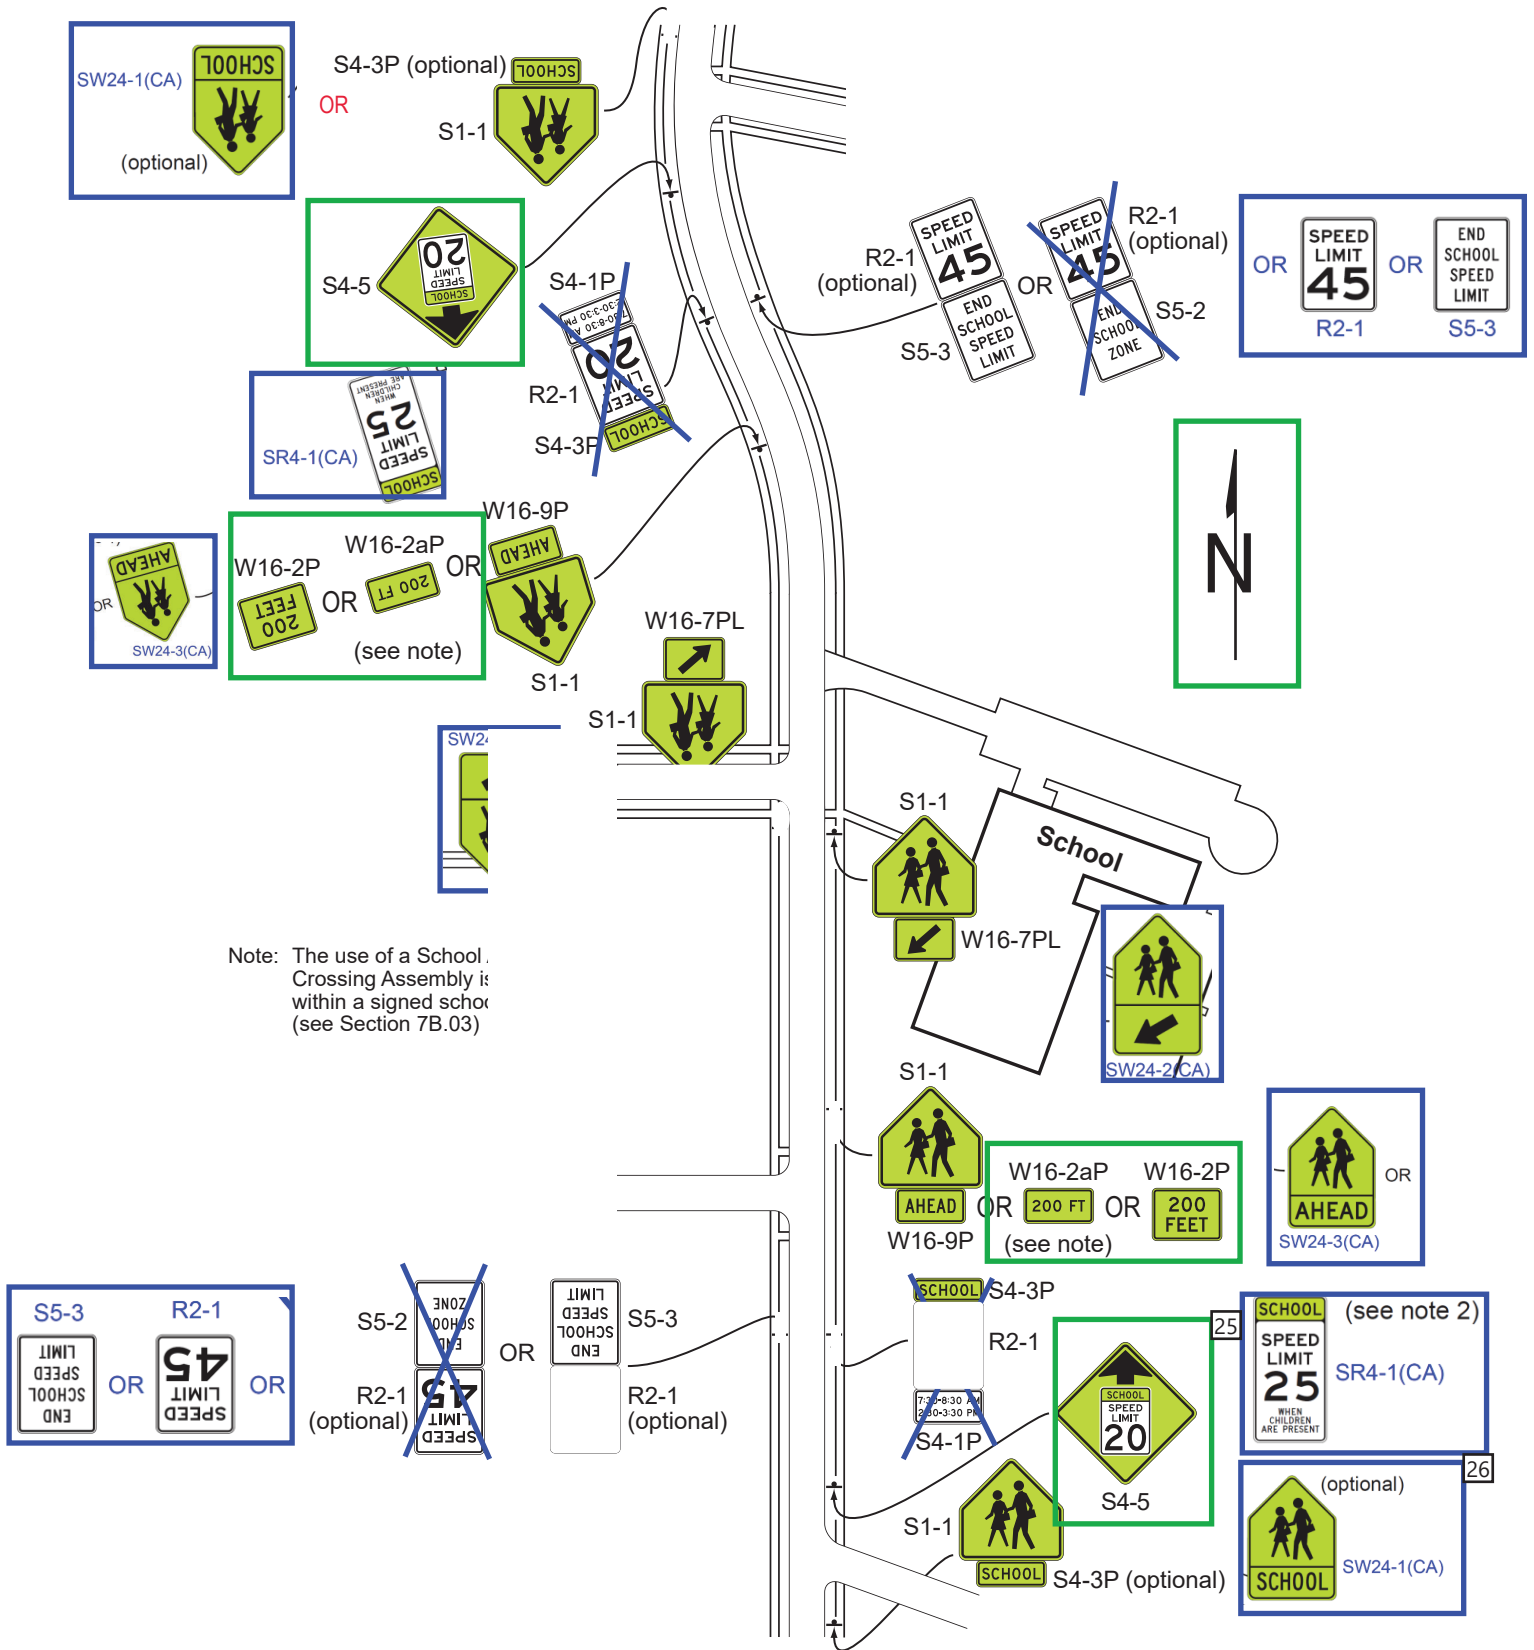
 Number: 4 Author: s116730 Subject: Text Box Date: 7/25/2024 9:48:13 AM
Figure 7B-1(CA). Signs in School Areas and at School Crossings

Figure 7B-2. Example of Signing for a School Zone with a School Speed Limit and a School Crossing



<input checked="" type="checkbox"/>	Number: 1	Author: s116730	Subject: Highlight	Date: 7/25/2024 9:48:20 AM
NMUTCD 2023 added sign codes for all signs, which were missing in NMUTCD 2009 figures				
<input checked="" type="checkbox"/>	Number: 2	Author: s116730	Subject: Highlight	Date: 7/25/2024 9:48:24 AM
NMUTCD 2023 changed NMUTCD 2009 Figure 7B-5 to 7B-2 and added sign codes for the signs shown in the figure.				
<input type="checkbox"/>	Number: 3	Author: s116730	Subject: Rectangle	Date: 7/10/2024 9:45:30 AM
Incorporated from CA MUTCD 2014R8 Figure 7B-5				
<input type="checkbox"/>	Number: 4	Author: s116730	Subject: Text Box	Date: 7/10/2024 9:43:42 AM
OR				
<input checked="" type="checkbox"/>	Number: 5	Author: s116730	Subject: Line	Date: 7/10/2024 9:37:58 AM
<input type="checkbox"/>	Number: 6	Author: s116730	Subject: Rectangle	Date: 7/10/2024 9:55:06 AM
Incorporated from CA MUTCD 2014R8 Figure 7B-5				
<input type="checkbox"/>	Number: 7	Author: s116730	Subject: Rectangle	Date: 7/14/2024 8:38:40 AM
NMUTCD 2023 added new sign				
<input checked="" type="checkbox"/>	Number: 8	Author: s116730	Subject: Line	Date: 7/10/2024 9:37:47 AM
<input checked="" type="checkbox"/>	Number: 9	Author: s116730	Subject: Line	Date: 7/10/2024 9:38:20 AM
<input checked="" type="checkbox"/>	Number: 10	Author: s116730	Subject: Line	Date: 7/10/2024 9:38:20 AM
<input type="checkbox"/>	Number: 11	Author: s116730	Subject: Rectangle	Date: 7/10/2024 9:55:55 AM
Incorporated from CA MUTCD 2014R8 Figure 7B-5				
<input type="checkbox"/>	Number: 12	Author: s116730	Subject: Rectangle	Date: 7/14/2024 8:40:44 AM
NMUTCD 2023 added new cardinal direction "N" arrow				
<input type="checkbox"/>	Number: 13	Author: s116730	Subject: Rectangle	Date: 7/13/2024 10:10:07 AM
NMUTCD 2023 added new plaques				
<input type="checkbox"/>	Number: 14	Author: s116730	Subject: Rectangle	Date: 7/10/2024 2:53:25 PM
Incorporated from CA MUTCD 2014R8 Figure 7B-5				
<input type="checkbox"/>	Number: 15	Author: s116730	Subject: Rectangle	Date: 7/10/2024 2:34:53 PM
Incorporated from CA MUTCD 2014R8 Figure 7B-5				
<input type="checkbox"/>	Number: 16	Author: s116730	Subject: Rectangle	Date: 7/10/2024 2:35:20 PM
Incorporated from CA MUTCD 2014R8 Figure 7B-5				
<input type="checkbox"/>	Number: 17	Author: s116730	Subject: Rectangle	Date: 7/10/2024 9:56:34 AM
Incorporated from CA MUTCD 2014R8 Figure 7B-5				
<input type="checkbox"/>	Number: 18	Author: s116730	Subject: Rectangle	Date: 7/13/2024 10:10:21 AM
NMUTCD 2023 added new plaques				
<input checked="" type="checkbox"/>	Number: 19	Author: s116730	Subject: Line	Date: 7/10/2024 9:51:04 AM
<input checked="" type="checkbox"/>	Number: 20	Author: s116730	Subject: Line	Date: 7/10/2024 9:50:49 AM
<input checked="" type="checkbox"/>	Number: 21	Author: s116730	Subject: Line	Date: 7/10/2024 9:40:05 AM
<input checked="" type="checkbox"/>	Number: 22	Author: s116730	Subject: Line	Date: 7/10/2024 9:39:53 AM
<input type="checkbox"/>	Number: 23	Author: s116730	Subject: Rectangle	Date: 7/10/2024 9:56:16 AM
Incorporated from CA MUTCD 2014R8 Figure 7B-5				
<input type="checkbox"/>	Number: 24	Author: s116730	Subject: Rectangle	Date: 7/10/2024 9:57:20 AM

Figure 7B-2. Example of Signing for a School Zone with a School Speed Limit and a School Crossing



Incorporated from CA MUTCD 2014R8 Figure 7B-5

Number: 25 Author: s116730 Subject: Rectangle Date: 7/13/2024 10:10:35 AM
NMUTCD 2023 added new sign

Number: 26 Author: s116730 Subject: Rectangle Date: 7/10/2024 9:56:45 AM
Incorporated from CA MUTCD 2014R8 Figure 7B-5

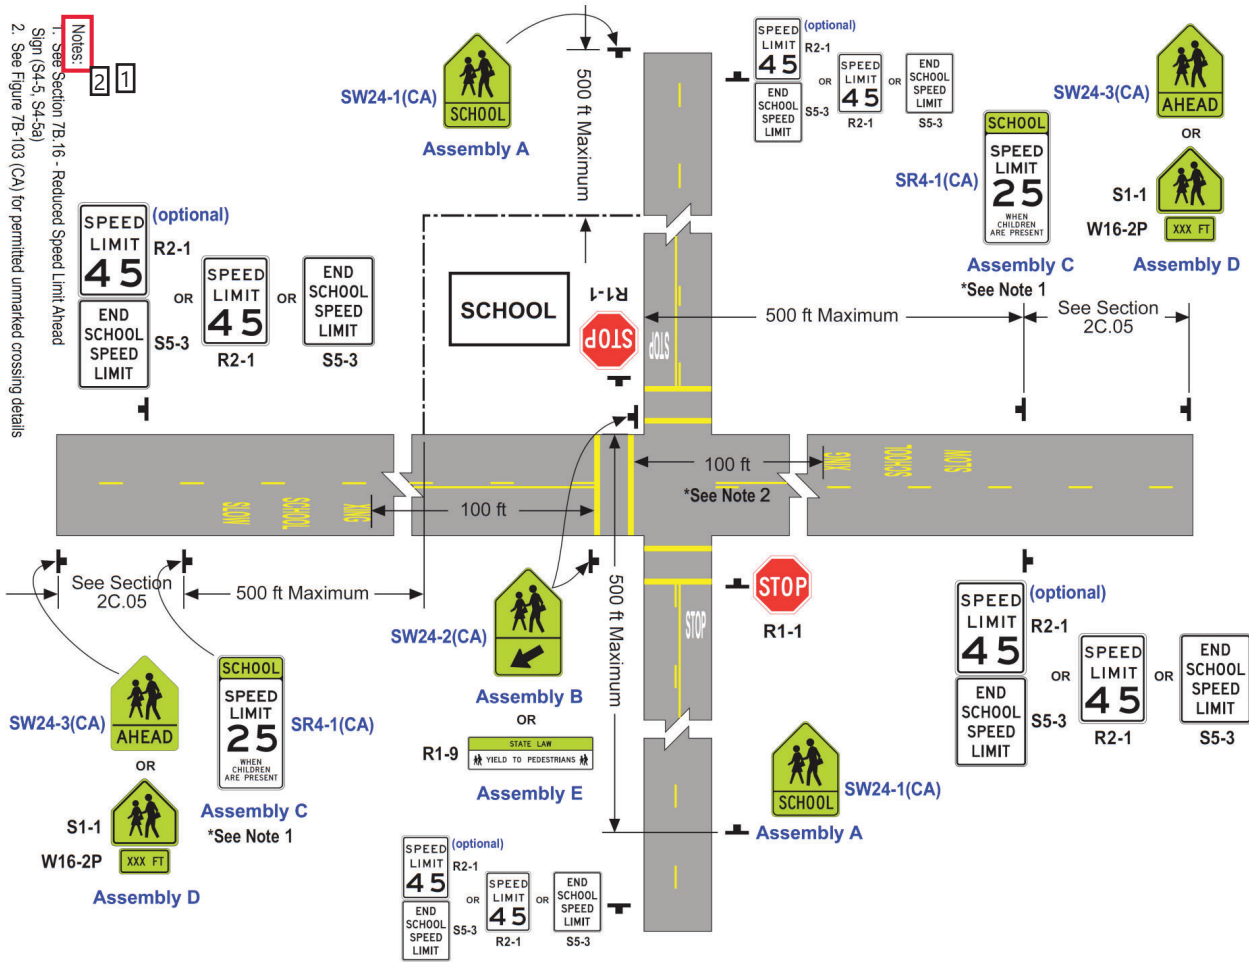


Figure 7B-2(CA) Example of Signing for a School Zone with a School Speed Limit and a School Crossing

Number: 1 Author: s116730 Subject: Rectangle Date: 7/10/2024 3:54:08 PM

Number: 2 Author: s116730 Subject: Rectangle Date: 7/10/2024 3:56:44 PM

Add new note:

3. See Section 7B.02 for Assembly A(CA), Section 7B.03 for Assemblies B(CA), D(CA) and E(CA), and Section 7B.05 for Assembly C.

Number: 3 Author: s116730 Subject: Text Box Date: 7/10/2024 3:39:15 PM

7B-2(CA)


Number: 4 Author: s116730 Subject: Line Date: 7/10/2024 3:52:15 PM

NMUTCD 2023 changed NMUTCD 2009 Figure 7B-5 to 7B-2. This figure is renumbered as 7B-2(CA) and is included in CA MUTCD 2026

Number: 5 Author: s116730 Subject: Highlight Date: 7/25/2024 9:49:13 AM

NMUTCD 2023 changed NMUTCD 2009 Figure 7B-5 to 7B-2. This figure is renumbered as 7B-2(CA) and is included in CA MUTCD 2026


Figure 7B-3. Example of Signing for a School Crossing Outside of a School Zone

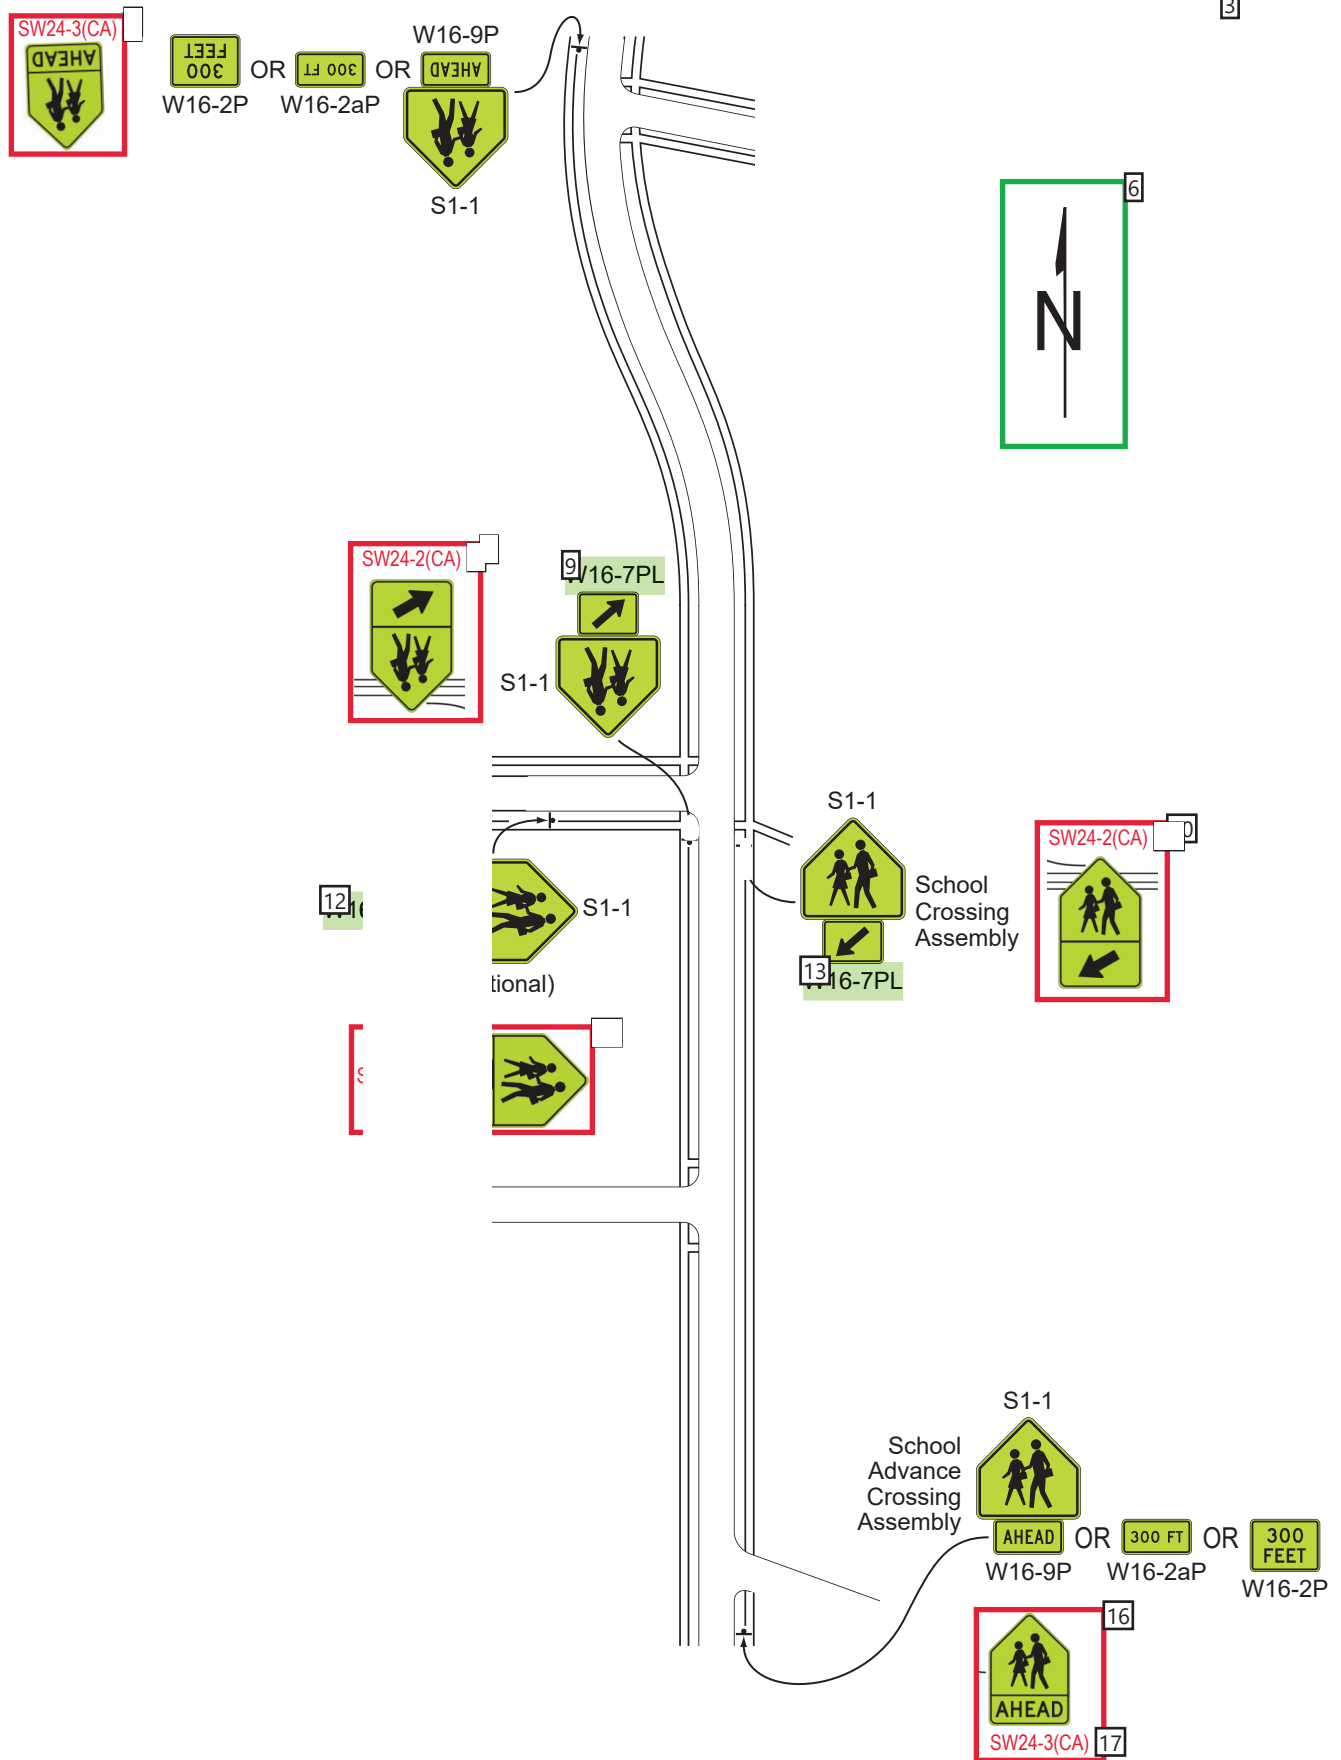

Page: 6


-
- Number: 1 Author: s116730 Subject: Highlight Date: 7/25/2024 9:49:29 AM
Options for CA signs that are combined with plaques (for all signs shown on this sheet) will be added
- NMUTCD 2023 added sign codes for all signs, which were missing in NMUTCD 2009 figures
-
- Number: 2 Author: s116730 Subject: Highlight Date: 7/25/2024 9:49:32 AM
NMUTCD 2023 changed NMUTCD 2009 Figure 7B-4 to 7B-3 and added sign codes for the signs shown in the figure.
-
- Number: 3 Author: s116730 Subject: Text Box Date: 7/10/2024 3:11:55 PM
-
- Number: 4 Author: s116730 Subject: Rectangle Date: 7/10/2024 3:20:12 PM
Add SW24-3(CA) Assembly D(CA) image
-
- Number: 5 Author: s116730 Subject: Text Box Date: 7/10/2024 2:56:21 PM
SW24-3(CA)
-
- Number: 6 Author: s116730 Subject: Rectangle Date: 7/14/2024 8:41:23 AM
NMUTCD 2023 added new cardinal direction "N" arrow
-
- Number: 7 Author: s116730 Subject: Rectangle Date: 7/10/2024 3:21:59 PM
Add SW24-2(CA) Assembly B(CA) image
-
- Number: 8 Author: s116730 Subject: Text Box Date: 7/10/2024 2:59:39 PM
SW24-2(CA)
-
- Number: 9 Author: s116730 Subject: Highlight Date: 7/25/2024 9:49:59 AM
NMUTCD 2023 changed the NMUTCD 2009 sign code "W16-7P" to "W16-7PL"
-
- Number: 10 Author: s116730 Subject: Rectangle Date: 7/10/2024 3:21:47 PM
Add SW24-2(CA) Assembly B(CA) image
-
- Number: 11 Author: s116730 Subject: Text Box Date: 7/10/2024 3:00:31 PM
SW24-2(CA)
-
- Number: 12 Author: s116730 Subject: Highlight Date: 7/25/2024 9:50:05 AM
NMUTCD 2023 changed the NMUTCD 2009 sign code "W16-6P" to "W16-6PR"
-
- Number: 13 Author: s116730 Subject: Highlight Date: 7/25/2024 9:50:09 AM
NMUTCD 2023 changed the NMUTCD 2009 sign code "W16-7P" to "W16-7PL"
-
- Number: 14 Author: s116730 Subject: Rectangle Date: 7/10/2024 3:23:06 PM
Add SW24-1(CA) Assembly A(CA) image
-
- Number: 15 Author: s116730 Subject: Text Box Date: 7/10/2024 3:05:01 PM
SW24-1(CA)
-
- Number: 16 Author: s116730 Subject: Rectangle Date: 7/10/2024 3:22:25 PM
Add SW24-3(CA) Assembly D(CA) image
-
- Number: 17 Author: s116730 Subject: Text Box Date: 7/10/2024 3:08:39 PM
SW24-3(CA)

Figure 7B-4. Example of Signing for a School Zone with a School Speed Limit and Higher Fines Only for Speeding

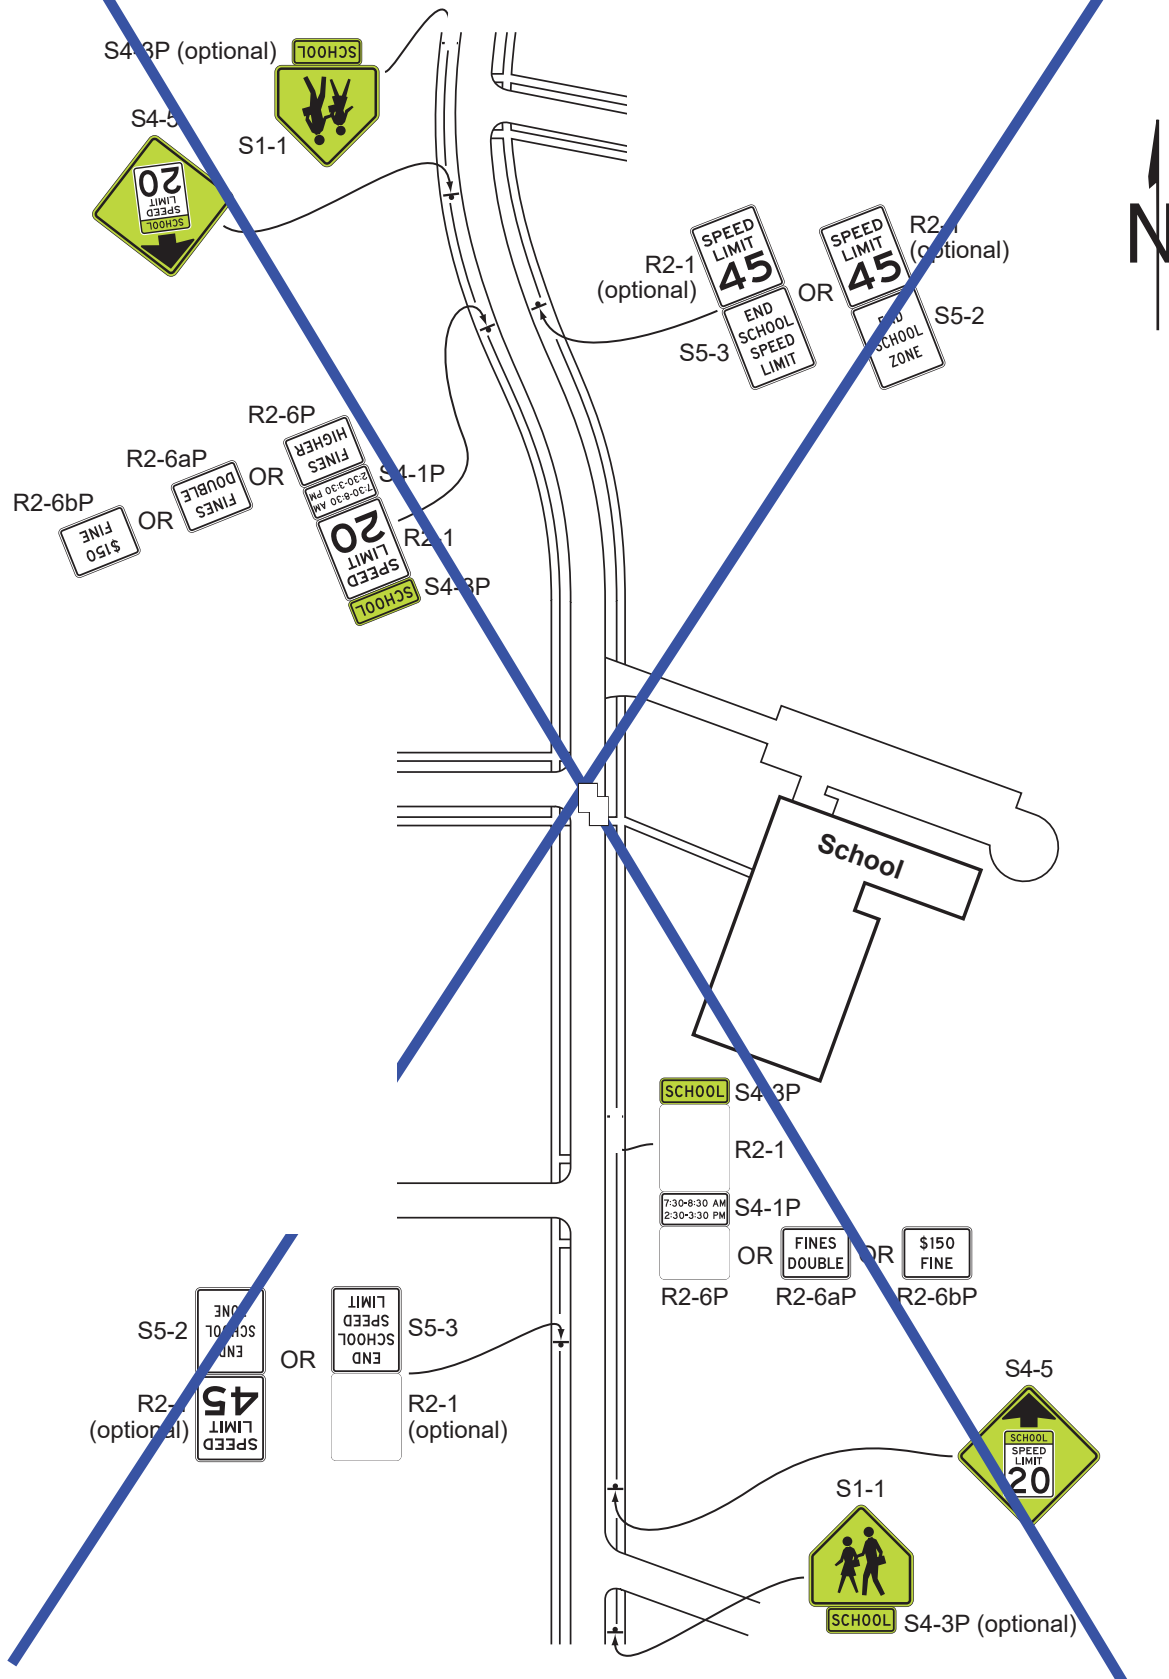

Number: 1 Author: s116730 Subject: Line Date: 7/10/2024 3:16:43 PM


Number: 2 Author: s116730 Subject: Line Date: 7/10/2024 3:16:27 PM

 Number: 3 Author: s116730 Subject: Highlight Date: 7/25/2024 9:50:21 AM
NMUTCD 2023 changed NMUTCD 2009 Figure number 7B-3 to 7B-4 and made other minor changes in the figure. This figure was shown in CA MUTCD 2014R8 with a blue "X".NMUTCD 2023 Figure 7B-4 is shown in CA MUTCD 2026 with a blue "X"

Since this figure is not applicable in CA, specific changes made in NMUTCD 2023 have not been identified.

Figure 7B-5. Example of Signing for a School Zone with Higher Fines for All Traffic Violations (Sheet 1 of 2)

A – Higher fines zone begins at the beginning of the school zone

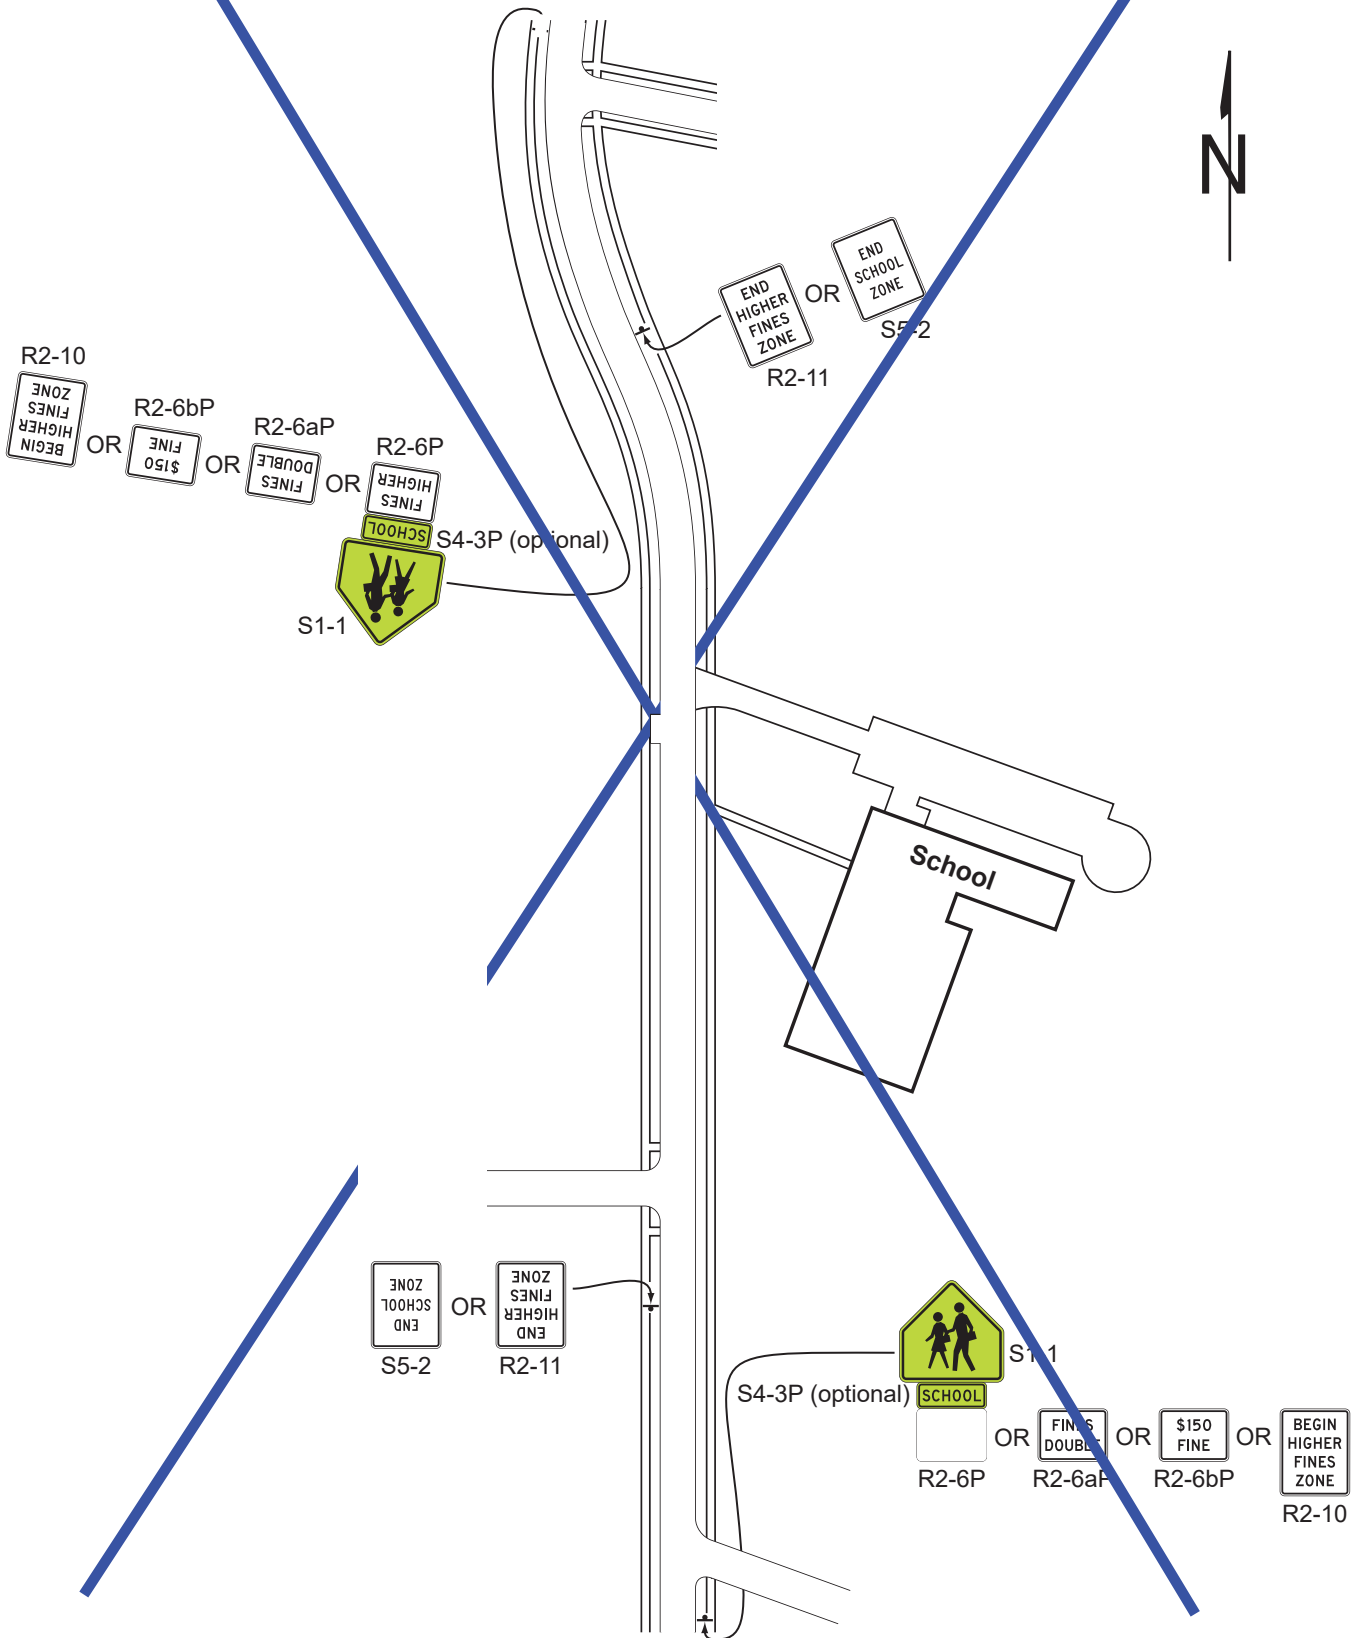

Number: 1 Author: s116730 Subject: Line Date: 7/10/2024 3:17:16 PM

Number: 2 Author: s116730 Subject: Line Date: 7/10/2024 3:17:16 PM


Number: 3 Author: s116730 Subject: Highlight Date: 7/25/2024 9:50:27 AM

NMUTCD 2023 changed NMUTCD 2009 Figure number 7B-2 to 7B-5 (Sheets 1 and 2 of 2) and made other minor changes in the figure. NMUTCD 2023 Figure 7B-5(Sheet 1 of 2) is shown in CA MUTCD 2026 with a blue "X"

Since this figure is not applicable in CA, specific changes made in NMUTCD 2023 have not been identified.

Figure 7B-5. Example of Signing for a School Zone with Higher Fines for All Traffic Violations (Sheet 2 of 2)

B – Higher fines zone begins after the beginning of the school zone

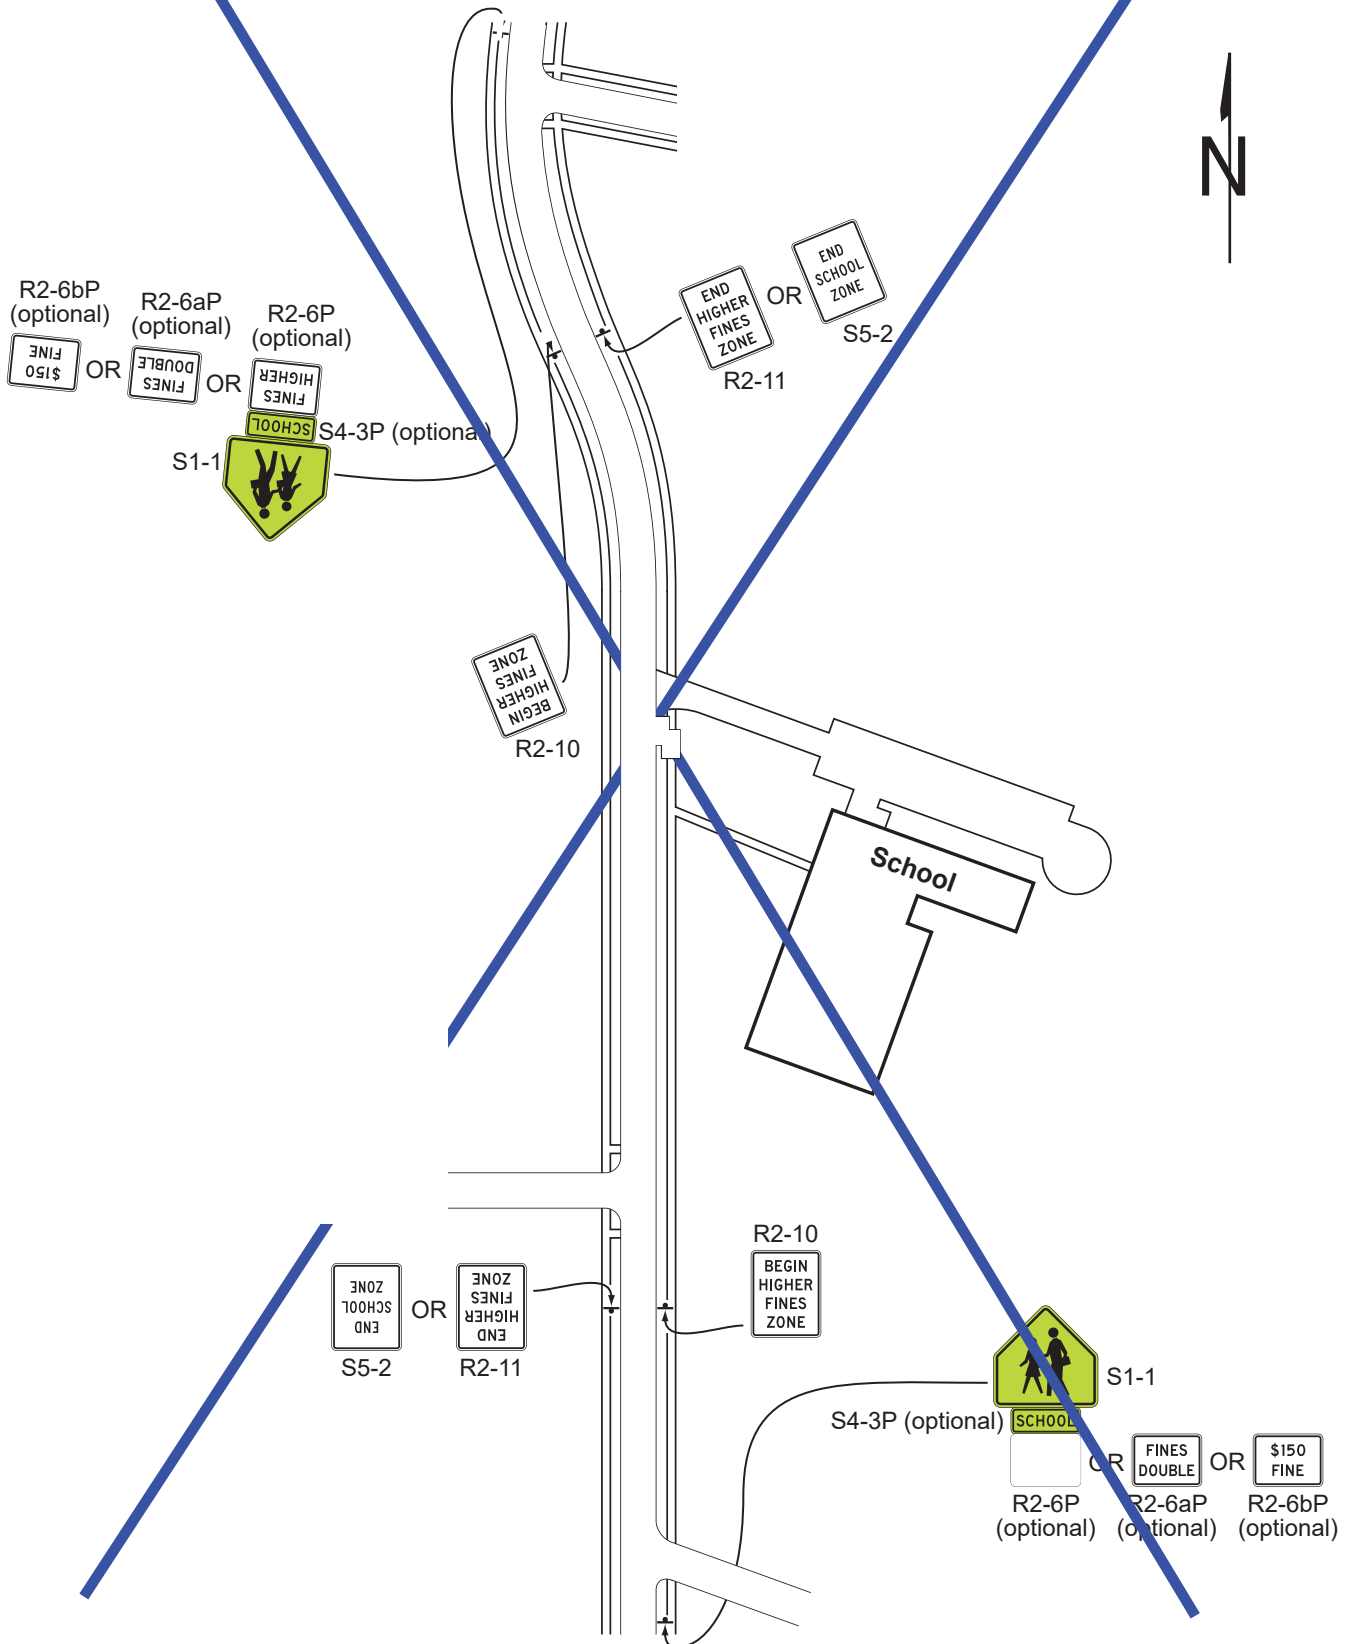

Number: 1 Author: s116730 Subject: Line Date: 7/10/2024 3:17:19 PM


Number: 2 Author: s116730 Subject: Line Date: 7/10/2024 3:17:19 PM

Number: 3 Author: s116730 Subject: Highlight Date: 7/25/2024 9:50:31 AM

NMUTCD 2023 changed NMUTCD 2009 Figure number 7B-2 to 7B-5 (Sheet 1 and 2 of 2) and made other minor changes in the figure. NMUTCD 2023 Figure 7B-5(Sheet 2 of 2) is shown in CA MUTCD 2026 with a blue "X"

Since this figure is not applicable in CA, specific changes made in NMUTCD 2023 have not been identified.

Figure 7B-101 (CA). Example of School Area Signs with Flashing Yellow Beacons

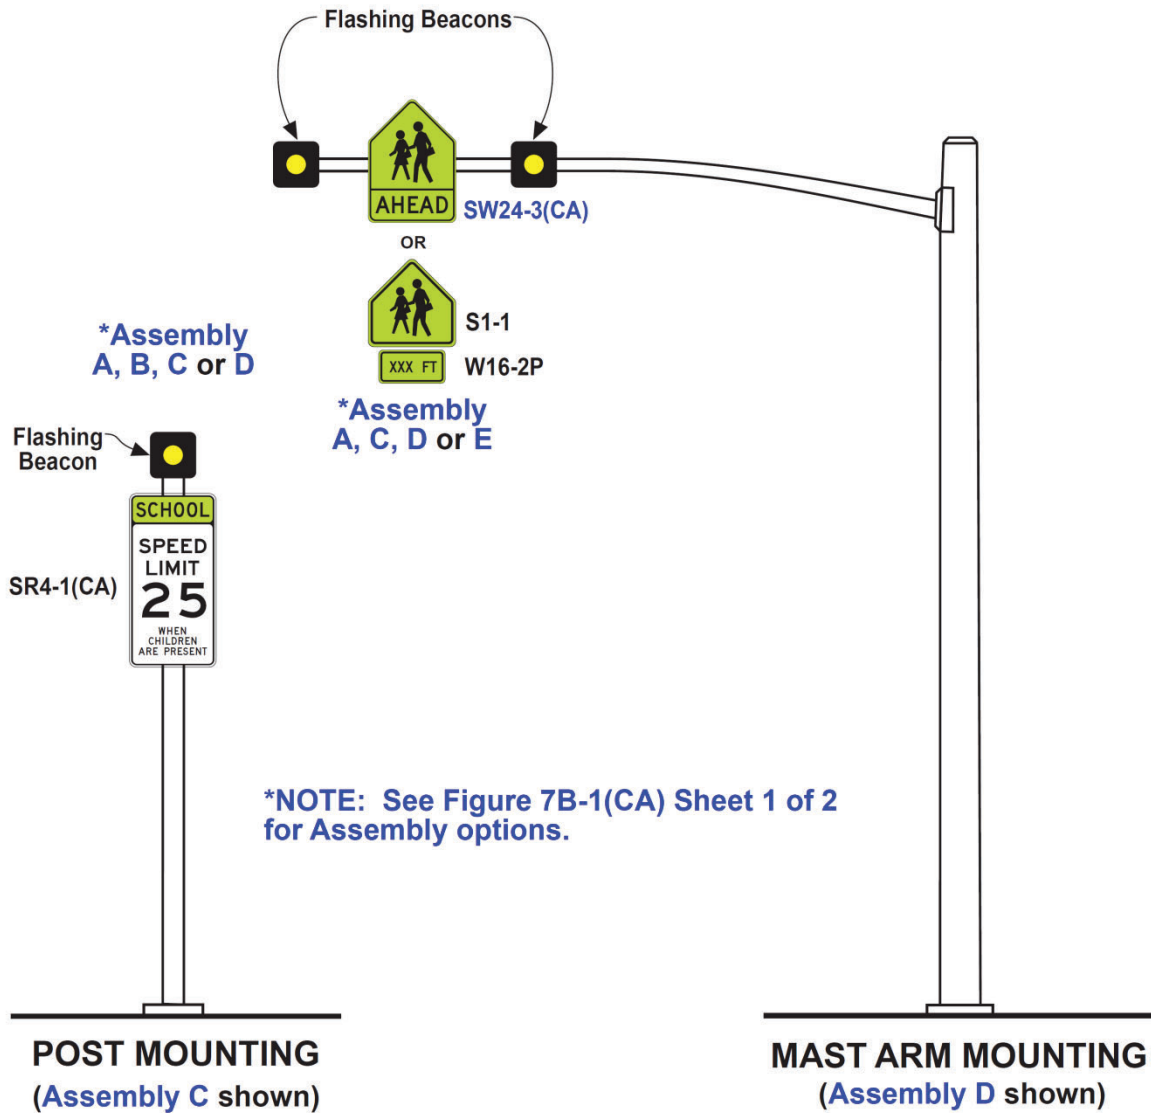


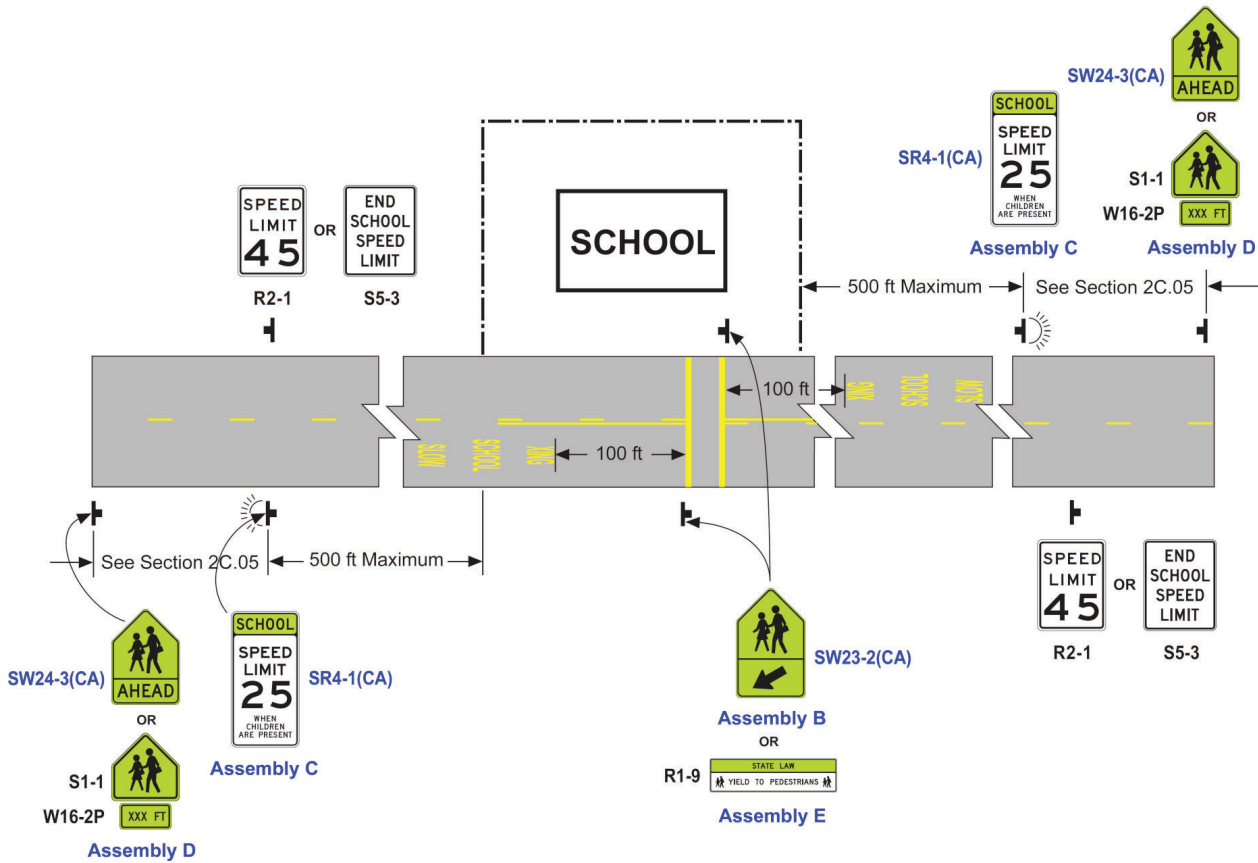


Figure 7B-102 (CA) Example of Signing for Traffic Control in School Areas with Flashing Yellow Beacons


Figure 7B-103(CA). Example of Signing for School Area Traffic Control with Extended and/or Reduced School Zone Speed Limits

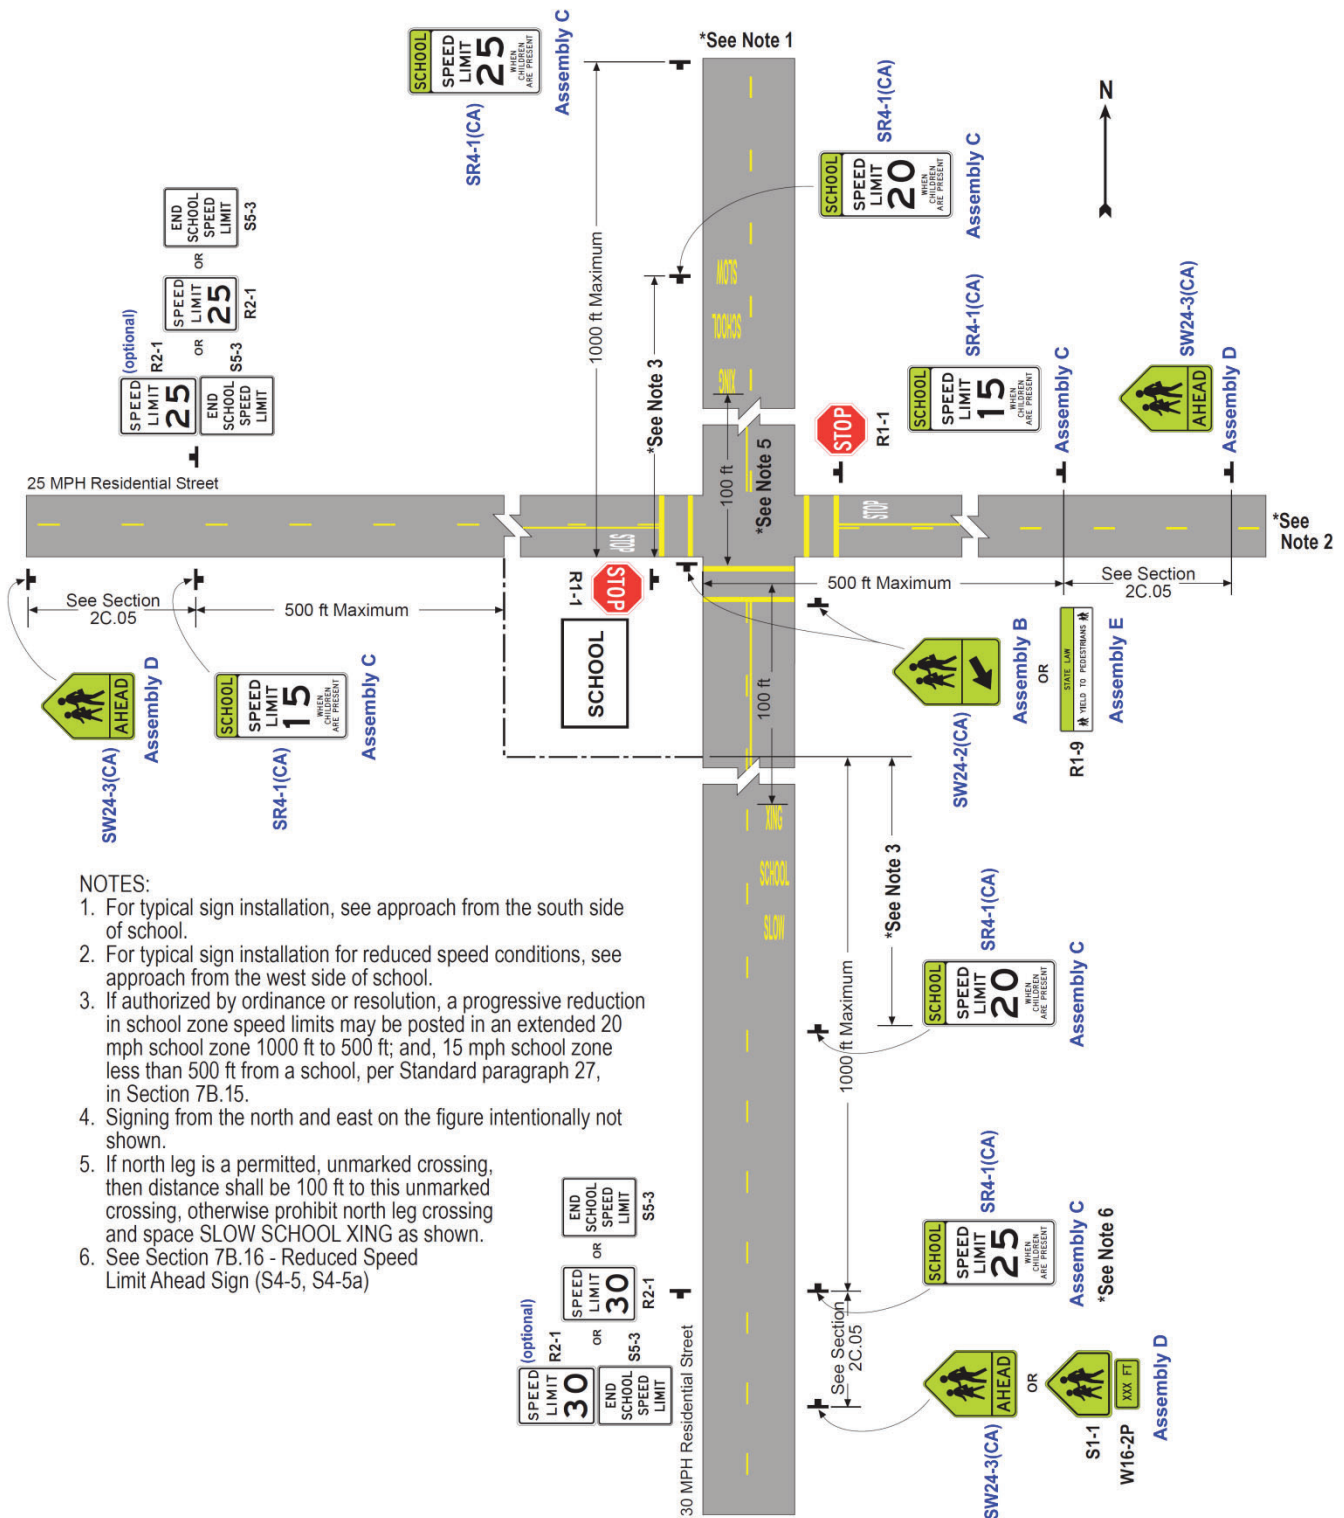

NOTES:

1. For typical sign installation, see approach from the south side of school.
2. For typical sign installation for reduced speed conditions, see approach from the west side of school.
3. If authorized by ordinance or resolution, a progressive reduction in school zone speed limits may be posted in an extended 20 mph school zone 1000 ft to 500 ft; and, 15 mph school zone less than 500 ft from a school, per Standard paragraph 27, in Section 7B.15.
4. Signing from the north and east on the figure intentionally not shown.
5. If north leg is a permitted, unmarked crossing, then distance shall be 100 ft to this unmarked crossing, otherwise prohibit north leg crossing and space SLOW SCHOOL XING as shown.
6. See Section 7B.16 - Reduced Speed Limit Ahead Sign (S4-5, S4-5a)

Figure 7B-104(CA). Example of Signing for School Crosswalk Warning Assembly

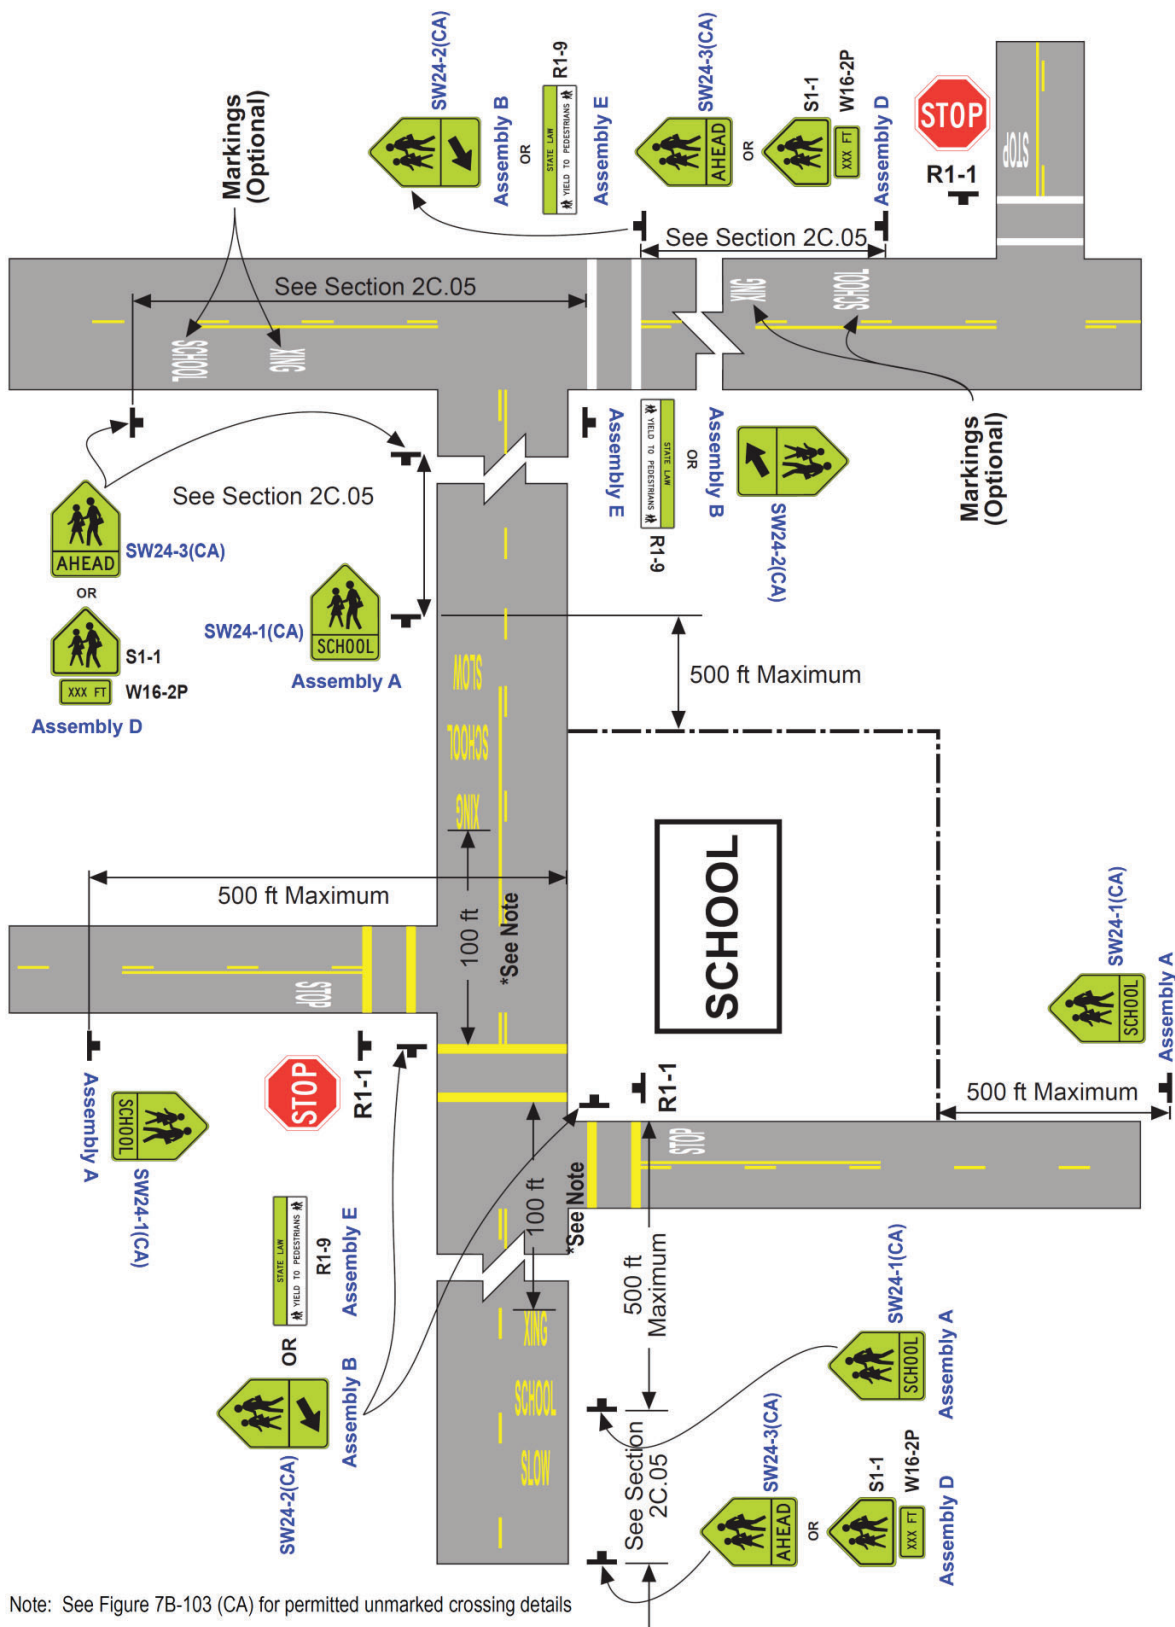

Note: See Figure 7B-103 (CA) for permitted unmarked crossing details

