


Figure 7A-1. Example of School Route Plan Map

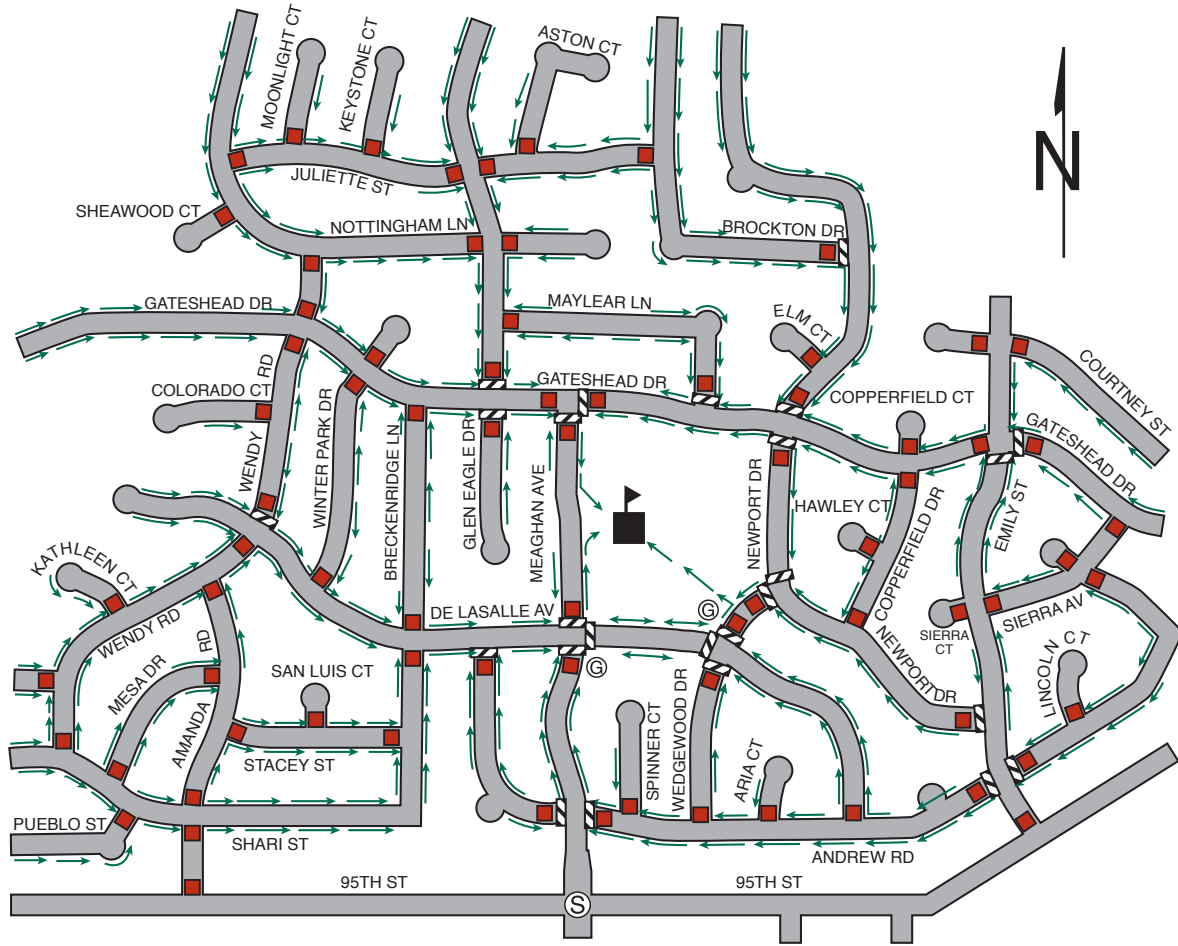

Legend

- |   |                  |   |                             |
|---|------------------|---|-----------------------------|
|  | School           |  | Signalized intersection     |
|  | Marked crosswalk |  | STOP or YIELD sign approach |
|  | Crossing guard   |  | Pedestrian route            |

# Summary of Comments on CAMUTCD 2026 7A Fig.pdf

---

Page: 1

---

 Number: 1      Author: s116730      Subject: Sticky Note      Date: 7/16/2024 7:44:33 AM

No change in NMUTCD 2023 Figure, when comparing to CA MUTCD 2014R8 (NMUTCD 2009) Figure. This figure is included in CA MUTCD 2026.