


# Summary of Comments on CAMUTCD 2026 7B Fig.pdf

Page: 1			
Number: 1	Author: s116730	Subject: Highlight	Date: 7/25/2024 9:46:00 AM
			nool Area Signs" to "Signs in School Areas and at School Crossings" and incorporated led sub-headings A thru D, expanding Figure 7B-1 into 2 sheets.
NMUTCD 2023	added sign codes for	all signs, which were	missing in NMUTCD 2009 figures
Number: 2 NMUTCD 2023	Author: s116730 added sub-heading A		Date: 7/25/2024 9:46:06 AM
TNumber: 3	Author: s116730	Subject: Cross-Out	: Date: 7/8/2024 11:11:18 AM
Number: 4 NMUTCD 2023 a	Author: s116730 added new text	Subject: Highlight	Date: 7/25/2024 9:46:13 AM
Number: 5	Author: s116730	Subject: Text Box	Date: 7/9/2024 3:32:56 PM
Number: 6	Author: s116730	Subject: Text Box	Date: 7/9/2024 4:02:20 PM
Number: 7	Author: s116730	Subject: Text Box	C(CA) Date: 7/9/2024 3:33:04 PM
/Number: 8	Author: s116730	Subject: Line	B(CA) Date: 7/8/2024 11:10:57 AM
Number: 9	Author: s116730	Subject: Line	Date: 7/8/2024 11:11:04 AM
Number: 10	Author: s116730	Subject: Text Box	Date: 7/9/2024 4:04:35 PM
Number: 11	Author: s116730	Subject: Text Box	Date: 7/9/2024 4:13:49 PM Assembly A(CA)
Number: 12 Add SR4-1(CA) i	Author: s116730 image in Assembly C(0		Date: 7/9/2024 4:03:24 PM
/Number: 13	Author: s116730	Subject: Line	Date: 7/9/2024 4:06:01 PM
Number: 14	Author: s116730	Subject: Line	Date: 7/8/2024 10:52:49 AM
<u>Number: 15</u>	Author: s116730	Subject: Line	Date: 7/8/2024 10:53:42 AM
Number: 16	Author: s116730	Subject: Line	Date: 7/8/2024 10:57:59 AM
/Number: 17	Author: s116730	Subject: Line	Date: 7/8/2024 10:57:59 AM
Number: 18	Author: s116730	Subject: Text Box	Date: 7/9/2024 3:56:43 PM
<u>Number: 19</u>	Author: s116730	Subject: Line	Date: 7/9/2024 4:08:27 PM
Number: 20	Author: s116730 ) image in Assembly E		Date: 7/9/2024 3:56:19 PM
Number: 21	Author: s116730	Subject: Line	Date: 7/8/2024 11:12:25 AM
Number: 22	Author: s116730	Subject: Line	Date: 7/8/2024 11:12:17 AM

## Comments from page 1 continued on next page

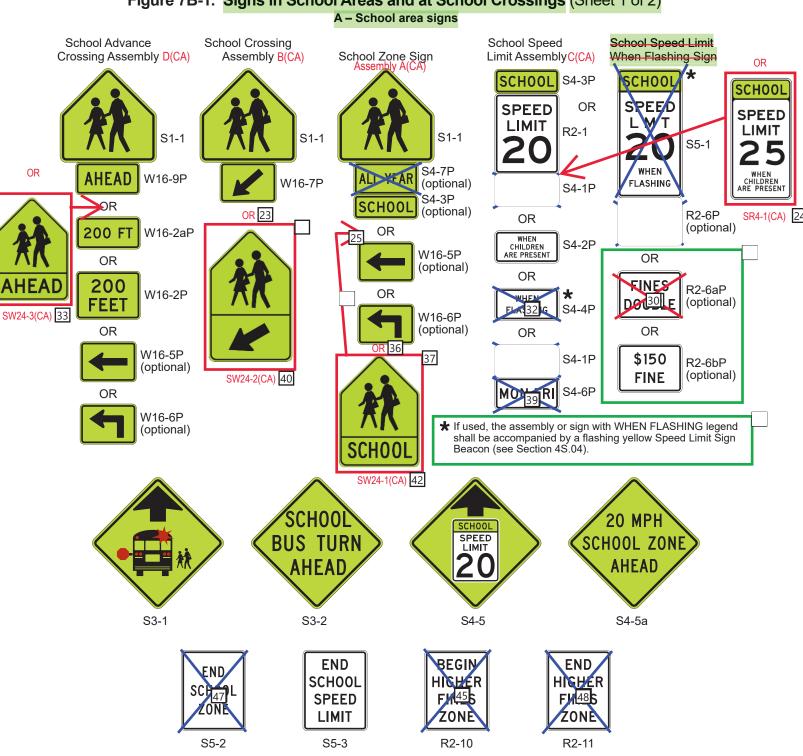

## Figure 7B-1. Signs in School Areas and at School Crossings (Sheet 1 of 2)

Number: 23	Author: s116730	Subject: Text Box	Date: 7/9/2024 3:57:09 PM
Number: 24	Author: s116730	Subject: Text Box	Date: 7/9/2024 4:04:01 PM SR4-1(CA)
Number: 25	Author: s116730	Subject: Line	Date: 7/9/2024 4:07:36 PM
Number: 26 Add SW24-2(CA)	Author: s116730 image in Assembly D		Date: 7/9/2024 3:59:42 PM -7P
Number: 27	Author: s116730	Subject: Line	Date: 7/9/2024 4:06:50 PM
Number: 28 NMUTCD 2023 a	Author: s116730	Subject: Rectangle	Date: 7/13/2024 10:03:54 AM
<u>Number: 29</u>	Author: s116730	Subject: Line	Date: 7/8/2024 11:16:39 AM
<u>Number: 30</u>	Author: s116730	Subject: Line	Date: 7/8/2024 11:16:39 AM
<u>Number: 31</u>	Author: s116730	Subject: Line	Date: 7/8/2024 10:57:28 AM
Number: 32	Author: s116730	Subject: Line	Date: 7/8/2024 10:57:13 AM
Number: 33	Author: s116730	Subject: Text Box	Date: 7/9/2024 3:56:26 PM
Number: 34	Author: s116730	Subject: Line	Date: 7/8/2024 10:58:34 AM
Number: 35	Author: s116730	Subject: Line	Date: 7/8/2024 10:58:34 AM
Number: 36	Author: s116730	Subject: Text Box	Date: 7/9/2024 3:57:52 PM
Number: 37	Author: s116730 Author: s116730 image in Assembly A	Subject: Rectangle	OR Date: 7/9/2024 3:47:20 PM
Number: 37	Author: s116730	Subject: Rectangle	OR Date: 7/9/2024 3:47:20 PM
Number: 37 Add SW24-1(CA)	Author: s116730 image in Assembly A	Subject: Rectangle (CA) between the S4	OR Date: 7/9/2024 3:47:20 PM -3P and W16-5P
Number: 37 Add SW24-1(CA)	Author: s116730 image in Assembly A Author: s116730	Subject: Rectangle (CA) between the S4 Subject: Line	OR Date: 7/9/2024 3:47:20 PM -3P and W16-5P Date: 7/8/2024 10:58:51 AM Date: 7/8/2024 10:58:51 AM Date: 7/9/2024 3:58:56 PM
Number: 37 Add SW24-1(CA) Number: 38	Author: s116730 image in Assembly A Author: s116730 Author: s116730 Author: s116730 Author: s116730	Subject: Rectangle (CA) between the S4 Subject: Line Subject: Line Subject: Text Box	OR Date: 7/9/2024 3:47:20 PM -3P and W16-5P Date: 7/8/2024 10:58:51 AM Date: 7/8/2024 10:58:51 AM
Number: 37 Add SW24-1(CA) <u>Number: 38</u> Number: 39	Author: s116730 image in Assembly A Author: s116730 Author: s116730 Author: s116730 Author: s116730	Subject: Rectangle (CA) between the S4 Subject: Line Subject: Line Subject: Text Box	OR         Date: 7/9/2024 3:47:20 PM         -3P and W16-5P         Date: 7/8/2024 10:58:51 AM         Date: 7/8/2024 10:58:51 AM         Date: 7/9/2024 3:58:56 PM         SW24-2(CA)         Date: 7/13/2024 10:04:44 AM         Date: 7/9/2024 3:57:21 PM
Number: 37 Add SW24-1(CA) Number: 38 Number: 39	Author: s116730 image in Assembly A Author: s116730 Author: s116730 Author: s116730 Author: s116730 dded new note	Subject: Rectangle (CA) between the S4 Subject: Line Subject: Line Subject: Text Box Subject: Rectangle	OR Date: 7/9/2024 3:47:20 PM -3P and W16-5P Date: 7/8/2024 10:58:51 AM Date: 7/8/2024 10:58:51 AM Date: 7/9/2024 3:58:56 PM SW24-2(CA) Date: 7/13/2024 10:04:44 AM
Number: 37         Add SW24-1(CA)         Number: 38         Number: 39         Number: 40         Number: 41         NUMUTCD 2023 a         Number: 42	Author: s116730 image in Assembly A Author: s116730 Author: s116730 Author: s116730 Author: s116730 dded new note Author: s116730	Subject: Rectangle (CA) between the S4 Subject: Line Subject: Line Subject: Text Box Subject: Rectangle Subject: Text Box	OR         Date: 7/9/2024 3:47:20 PM         -3P and W16-5P         Date: 7/8/2024 10:58:51 AM         Date: 7/8/2024 10:58:51 AM         Date: 7/8/2024 10:58:51 AM         Date: 7/9/2024 3:58:56 PM         SW24-2(CA)         Date: 7/13/2024 10:04:44 AM         Date: 7/9/2024 3:57:21 PM         SW24-1(CA)
Number: 37         Add SW24-1(CA)         Number: 38         Number: 39         Number: 40         Number: 41         NMUTCD 2023 a         Number: 42         Number: 43	Author: s116730 image in Assembly A Author: s116730 Author: s116730 Author: s116730 Author: s116730 dded new note Author: s116730 Author: s116730	Subject: Rectangle (CA) between the S4 Subject: Line Subject: Line Subject: Text Box Subject: Rectangle Subject: Text Box Subject: Line	OR         Date: 7/9/2024 3:47:20 PM         -3P and W16-5P         Date: 7/8/2024 10:58:51 AM         Date: 7/8/2024 10:58:51 AM         Date: 7/9/2024 3:58:56 PM         SW24-2(CA)         Date: 7/13/2024 10:04:44 AM         Date: 7/9/2024 3:57:21 PM         SW24-1(CA)         Date: 7/8/2024 11:13:52 AM
Number: 37         Add SW24-1(CA)         Number: 38         Number: 39         Number: 40         Number: 41         NUMUTCD 2023 a         Number: 42         Number: 43         Number: 44	Author: s116730 image in Assembly A Author: s116730 Author: s116730 Author: s116730 Author: s116730 dded new note Author: s116730 Author: s116730 Author: s116730	Subject: Rectangle (CA) between the S4 Subject: Line Subject: Line Subject: Text Box Subject: Rectangle Subject: Text Box Subject: Line Subject: Line	OR         Date: 7/9/2024 3:47:20 PM         -3P and W16-5P         Date: 7/8/2024 10:58:51 AM         Date: 7/8/2024 10:58:51 AM         Date: 7/9/2024 3:58:56 PM         SW24-2(CA)         Date: 7/13/2024 10:04:44 AM         Date: 7/9/2024 3:57:21 PM         SW24-1(CA)         Date: 7/8/2024 11:13:52 AM         Date: 7/8/2024 11:13:18 AM
Number: 37         Add SW24-1(CA)         Number: 38         Number: 39         Number: 40         Number: 40         Number: 41         NUMUTCD 2023 a         Number: 42         Number: 43         Number: 44         Number: 45	Author: s116730 image in Assembly A Author: s116730 Author: s116730 Author: s116730 Author: s116730 dded new note Author: s116730 Author: s116730 Author: s116730	Subject: Rectangle (CA) between the S4 Subject: Line Subject: Line Subject: Text Box Subject: Rectangle Subject: Text Box Subject: Line Subject: Line Subject: Line	OR         Date: 7/9/2024 3:47:20 PM         -3P and W16-5P         Date: 7/8/2024 10:58:51 AM         Date: 7/8/2024 10:58:51 AM         Date: 7/9/2024 3:58:56 PM         SW24-2(CA)         Date: 7/13/2024 10:04:44 AM         Date: 7/9/2024 3:57:21 PM         SW24-1(CA)         Date: 7/8/2024 11:13:52 AM         Date: 7/8/2024 11:13:52 AM         Date: 7/8/2024 11:13:52 AM

## Comments from page 1 continued on next page




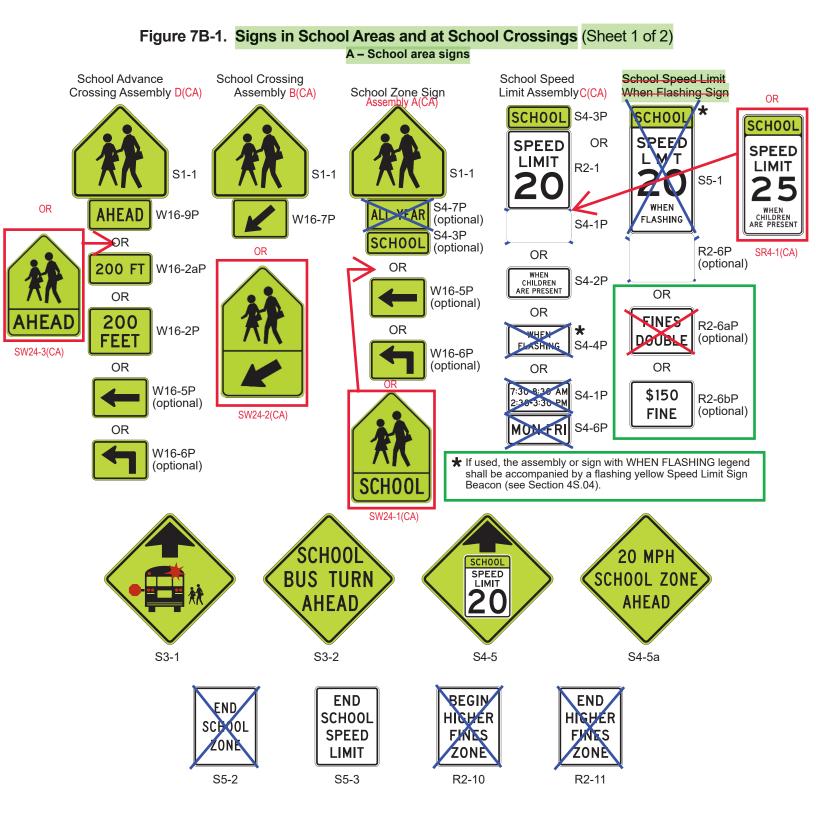


Figure 7B-1. Signs in School Areas and at School Crossings (Sheet 2 of 2)

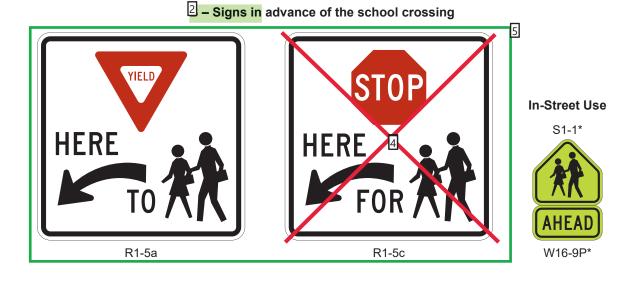

6 - In-street signs at the school crossing

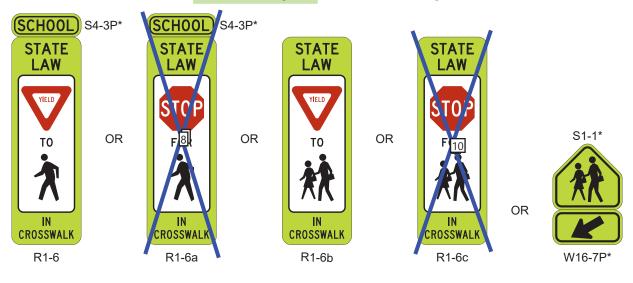

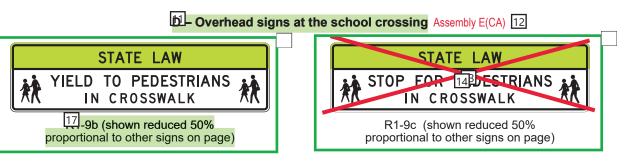


### Notes:

- 1. The use of the STATE LAW legend is optional on the R1-6 series and R1-9 series signs (see Section 7B.03).
- The use of the SCHOOL plaque above the R1-6 and R1-6a signs is optional.
   20 ns are shown in proportion to their designated sizes unless otherwise noted.

*Reduced size use (see Secti	signs 18 in-street on 7B.03):
S1-1	12 x 12 inches
S4-3P	12 x 4 inches
W16-7P	12 x 6 inches
W16-9P	12 x 6 inches

Mumber: 1	Author: s116730		Date: 7/25/2024 9:46:47 AM
			ool Area Signs" to "Signs in School Areas and at School Crossings" and incorporated
signs from NMU	ITCD 2009 Figures 7B	-1 and 7B-6 and add	ed sub-headings A thru D, expanding Figure 7B-1 into 2 sheets.
NMUTCD 2023 a	added sign codes for	all signs, which were	missing in NMUTCD 2009 figures
Number: 2	Author: s116730	Subject: Highlight	Date: 7/25/2024 9:46:51 AM
	changed sub-heading		
	5		
/Number: 3	Author: s116730	Subject: Line	Date: 7/10/2024 8:44:02 AM
/Number: 4	Author: s116730	Subject: Line	Date: 7/10/2024 8:44:02 AM
Number: 5	Author: s116730	Subject: Rectangle	Date: 7/13/2024 10:07:09 AM
NMUTCD 2023 a	idded new signs		
Mumber: 6	Author: s116730	Subject: Highlight	Date: 7/25/2024 9:47:03 AM
	changed sub-heading		
Number: 7	Author: s116730	Subject: Line	Date: 7/14/2024 8:17:45 AM
Number. 7	Author: 3110750	Subject. Line	Date. 1/14/2024 0.11.45 AM
N	A 11 11(720	C his shall be	
/Number: 8	Author: s116730	Subject: Line	Date: 7/14/2024 8:17:45 AM
/Number: 9	Author: s116730	Subject: Line	Date: 7/14/2024 8:17:45 AM
/Number: 10	Author: s116730	Subject: Line	Date: 7/14/2024 8:17:45 AM
-			
Mumber: 11	Author: s116730	Subject: Highlight	Date: 7/25/2024 9:47:07 AM
MMUTCD 2023 a	added sub-heading D		
Number: 12	Author: s116730	Subject: Text Box	Date: 7/9/2024 4:12:53 PM
	7.00101.0110700	Bubjeet. Text Box	Assembly E(CA)
Number: 13	Author: s116730	Subject: Line	Date: 7/10/2024 8:46:35 AM
	Author: \$110750	Subject. Line	Date. 7/10/2024 0.40.35 Alvi
	116700		
/Number: 14	Author: s116730	Subject: Line	Date: 7/10/2024 8:46:24 AM
Number: 15	Author: s116730	Subject: Rectangle	Date: 7/13/2024 10:07:36 AM
<sup></sup> NMUTCD 2023 a	idded new signs		
Number: 16	Author: s116730	Subject: Rectangle	Date: 7/13/2024 10:07:27 AM
MMUTCD 2023 a	dded text "IN CROSS	WALK" as 3rd line in	the sign
Mumber: 17	Author: s116730	Subject: Highlight	Date: 7/25/2024 9:47:24 AM
			2009 to R1-9b and added this text description.
Number: 18	Author: s116730	Subject: Highlight	Date: 7/25/2024 0:47:22 AM
Number: 18	Autiol. 5110750		Date: 7/25/2024 9:47:33 AM
		<u> </u>	
Number: 19	Author: s116730		Date: 7/25/2024 9:47:28 AM viously was in NMUTCD 2009 Figure 7B-6.
		Note # 1. Note # 1 pre	viousiy was in MNOTCD 2003 FIGURE / D-0.
Number: 20	Author: s116730	Subject: Highlight	Date: 7/25/2024 9:47:38 AM

NMUTCD 2023 added new note

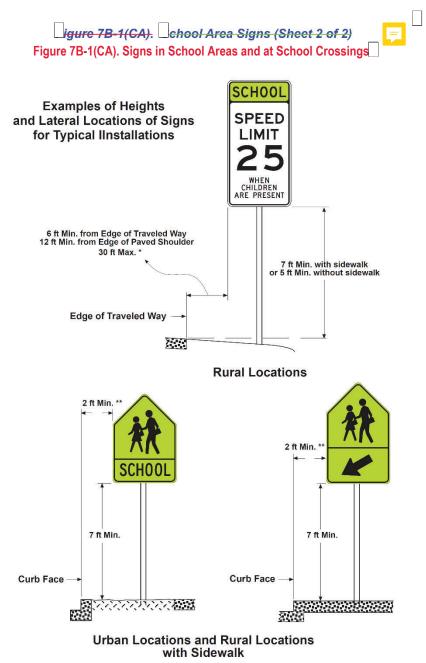

### NOTES:

- (\*) When clear roadside recovery areas are provided, signs shall be placed as far from the edge of traveled way as possible, up to a maximum of 30 ft. When possible they shall be placed in locations less likely to be hit by a vehicle leaving the traveled way. Signs should not be closer than 6 ft from the edge of a paved shoulder, or if none, 12 ft from the edge of the traveled way.
- (\*\*) In urban areas, where sidewalk width is limited or existing poles are close to the curb, a clearance of 1 ft from the curb face is permissible.

 Number: 1
 Author: s116730
 Subject: Sticky Note
 Date: 7/16/2024 7:58:04 AM

 Figure name changed to match NMUTCD 2023 Figure 7B-1 name and text for "(Sheet 2 of 2)" is deleted.

This figure is included in CA MUTCD 2026.


TNumber: 2 Author: s116730 Subject: Cross-Out Date: 7/10/2024 8:41:50 AM

 Number: 3
 Author: s116730
 Subject: Cross-Out
 Date: 7/25/2024 9:48:03 AM

 NMUTCD 2023 changed the title of Figure 7B-1 from "School Area Signs" to "Signs in School Areas and at School Crossings"


 Number: 4
 Author: s116730
 Subject: Text Box
 Date: 7/25/2024 9:48:13 AM

 Figure 7B-1(CA). Signs in School Areas and at School Crossings

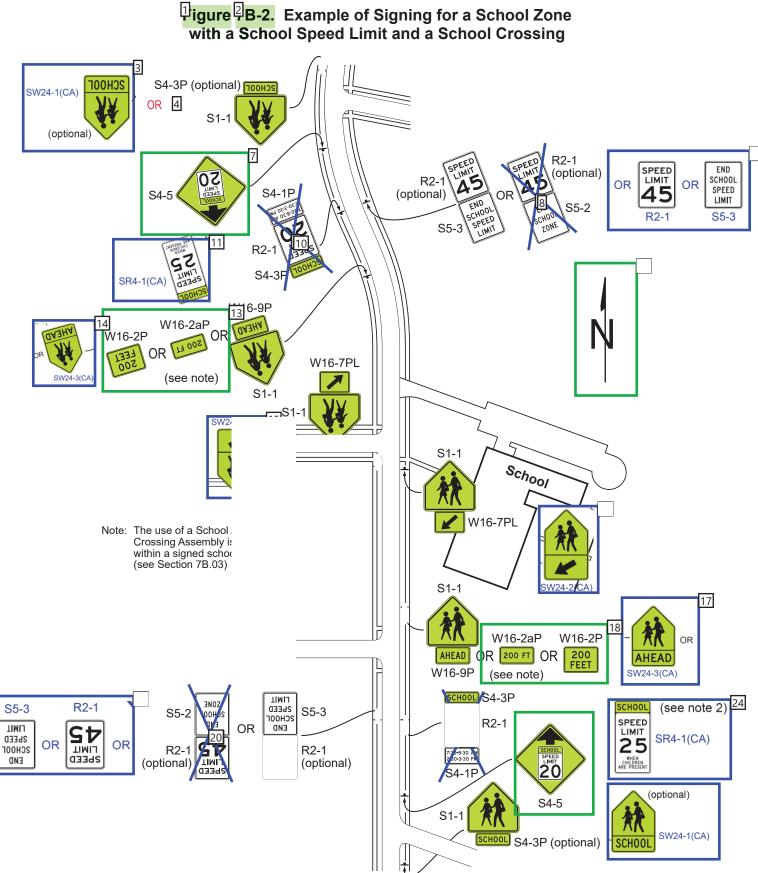

	Author: s116730		Date: 7/25/2024 9:48:20 AM missing in NMUTCD 2009 figures
	Author: s116730	•	Date: 7/25/2024 9:48:24 AM
			2 and added sign codes for the signs shown in the figure.
	Author: s116730		Date: 7/10/2024 9:45:30 AM
Incorporated from C		5	Date: 7/10/2024 0:42:42 AM
Number: 4	Author: s116730	Subject: Text Box	Date: 7/10/2024 9:43:42 AM OR
/Number: 5	Author: s116730	Subject: Line	Date: 7/10/2024 9:37:58 AM
Number: 6	Author: s116730	Subject: Rectangle	Date: 7/10/2024 9:55:06 AM
Incorporated from C			
Number: 7 NMUTCD 2023 add	Author: s116730	Subject: Rectangle	Date: 7/14/2024 8:38:40 AM
	Author: s116730	Subject: Line	Date: 7/10/2024 9:37:47 AM
	7.44101. 3110730	Subject. Line	
/Number: 9	Author: s116730	Subject: Line	Date: 7/10/2024 9:38:20 AM
Number: 10	Author: s116730	Subject: Line	Date: 7/10/2024 9:38:20 AM
Number: 11 Incorporated from (	Author: s116730		Date: 7/10/2024 9:55:55 AM
•	Author: s116730	5	Date: 7/14/2024 8:40:44 AM
NMUTCD 2023 adde			
Number: 13 NMUTCD 2023 add	Author: s116730	Subject: Rectangle	Date: 7/13/2024 10:10:07 AM
	Author: s116730	Subject: Rectangle	Date: 7/10/2024 2:53:25 PM
Incorporated from C			
Number: 15 Incorporated from 0	Author: s116730		Date: 7/10/2024 2:34:53 PM
·	Author: s116730	5	Date: 7/10/2024 2:35:20 PM
Incorporated from C			
	Author: s116730		Date: 7/10/2024 9:56:34 AM
Incorporated from C	A MUICD 2014R8 Author: s116730	-	Date: 7/13/2024 10:10:21 AM
NMUTCD 2023 adde			
<u>Number: 19</u>	Author: s116730	Subject: Line	Date: 7/10/2024 9:51:04 AM
Number: 20	Author: s116730	Subject: Line	Date: 7/10/2024 9:50:49 AM
Tumber, 20	, action. 5110750	Subject. Line	
Number: 21	Author: s116730	Subject: Line	Date: 7/10/2024 9:40:05 AM
Number: 22	Author: s116730	Subject: Line	Date: 7/10/2024 9:39:53 AM
Number: 23 Incorporated from 0	Author: s116730		Date: 7/10/2024 9:56:16 AM
·	Author: s116730	5	Date: 7/10/2024 9:57:20 AM

## Comments from page 4 continued on next page

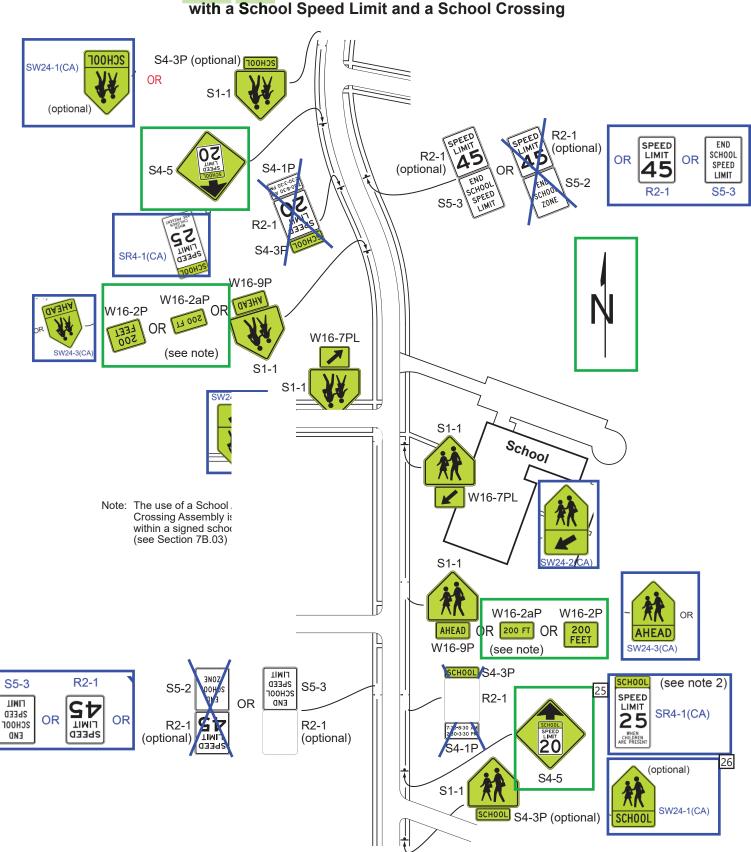

# Figure 7B-2. Example of Signing for a School Zone with a School Speed Limit and a School Crossing

Incorporated from CA MUTCD 2014R8 Figure 7B-5


Number: 25 Author: s116730 Subject: Rectangle Date: 7/13/2024 10:10:35 AM

NMUTCD 2023 added new sign

Г

Г

Number: 26 Author: s116730 Subject: Rectangle Date: 7/10/2024 9:56:45 AM Incorporated from CA MUTCD 2014R8 Figure 7B-5

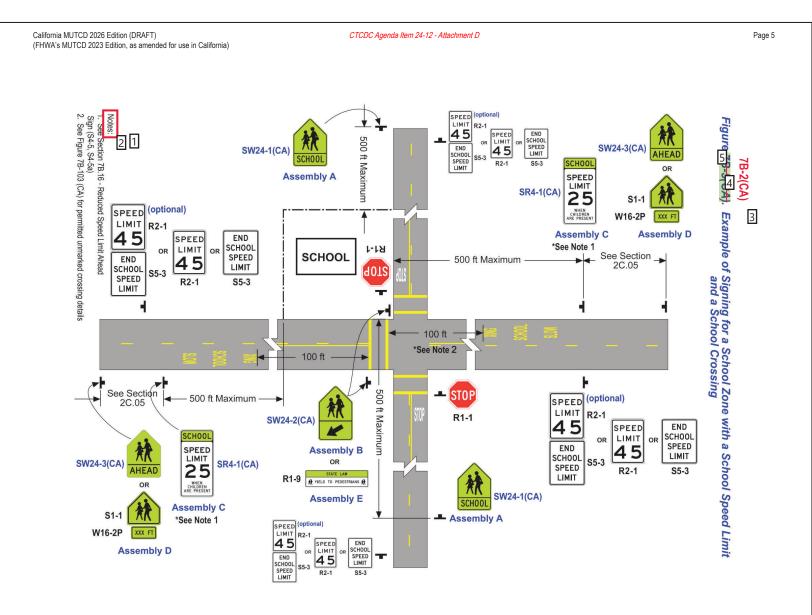


Chapter 7B – Signs (DRAFT) Figures Part 7 – Traffic Control for School Areas CTCDC Agenda Item 24-12 - Attachment D

October 15, 2024


Number: 1	Author: s116730	Subject: Rectangle	Date: 7/10/2024 3:54:08 PM
Number: 2	Author: s116730	Subject: Rectangle	Date: 7/10/2024 3:56:44 PM
Add new note: 3. See Section 7B.	)2 for Assembly A(C/	A), Section 7B.03 for A	Assemblies B(CA), D(CA) and E(CA), and Section 7B.05 for Assembly C.
Number: 3	Author: s116730	Subject: Text Box	Date: 7/10/2024 3:39:15 PM
			7B-2(CA)
Number: 4	Author: s116730	Subject: Line	Date: 7/10/2024 3:52:15 PM
NMUTCD 2023 ch	anged NMUTCD 20	09 Figure 7B-5 to 7B	-2. This figure is renumbered as 7B-2(CA) and is included in CA MUTCD 2026
Number: 5	Author: s116730	Subject: Highlight	Date: 7/25/2024 9:49:13 AM

NMUTCD 2023 changed NMUTCD 2009 Figure 7B-5 to 7B-2. This figure is renumbered as 7B-2(CA) and is included in CA MUTCD 2026



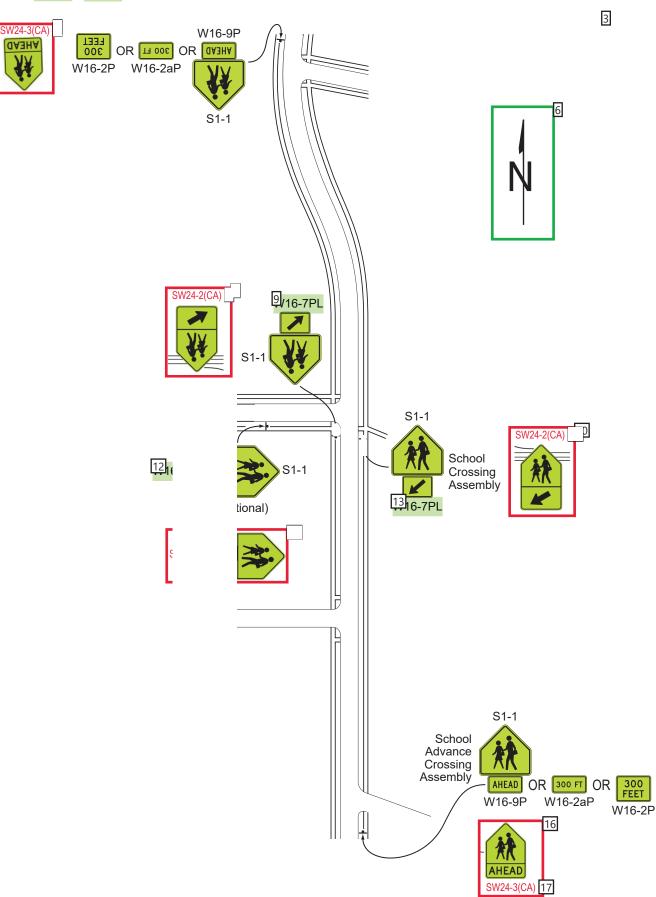

Number: 1	Author: s116730	Subject: Highlight	Date: 7/25/2024 9:49:29 AM
Options for CA	signs that are combi	ned with plaques (f	for all signs shown on this sheet) will be added
NMUTCD 2023 a	dded sign codes for a	all signs, which were	e missing in NMUTCD 2009 figures
Number: 2	Author: s116730	Subject: Highlight	Date: 7/25/2024 9:49:32 AM
MMUTCD 2023 c	hanged NMUTCD 200	09 Figure 7B-4 to 7B	B-3 and added sign codes for the signs shown in the figure.
Number: 3	Author: s116730	Subject: Text Box	Date: 7/10/2024 3:11:55 PM
Number: 4	Author: s116730		e Date: 7/10/2024 3:20:12 PM
Add SW24-3(CA)	Assembly D(CA) imag	je	
Number: 5	Author: s116730	Subject: Text Box	
			SW24-3(CA)
Number: 6	Author: s116730 dded new cardinal dir		e Date: 7/14/2024 8:41:23 AM
$\frac{\text{Number: 7}}{\text{Add SW24 2(CA)}}$	Author: s116730 Assembly B(CA) images		e Date: 7/10/2024 3:21:59 PM
Number: 8	Author: s116730	Subject: Text Box	Date: 7/10/2024 2:59:39 PM SW24-2(CA)
	11(720		
Number: 9	Author: s116730		Date: 7/25/2024 9:49:59 AM /16-7P" to "W16-7PL"
	5	5	
$\boxed{\text{Number: 10}}_{\text{Add SW24.2(CA)}}$	Author: s116730 Assembly B(CA) imag		e Date: 7/10/2024 3:21:47 PM
Number: 11	Author: s116730	Subject: Text Box	Date: 7/10/2024 3:00:31 PM SW24-2(CA)
Number: 12	Author: s116730 hanged the NMUTCD		Date: 7/25/2024 9:50:05 AM
	5	5	
Number: 13	Author: s116730		Date: 7/25/2024 9:50:09 AM /16-7P" to "W16-7PL"
	nanged the NMUTCL	2009 sign code w	/16-7P to W16-7PL
Number: 14	Author: s116730		e Date: 7/10/2024 3:23:06 PM
Add SW24-1(CA)	) Assembly A(CA) ima	ge	
Number: 15	Author: s116730	Subject: Text Box	Date: 7/10/2024 3:05:01 PM
			SW24-1(CA)
Number: 16	Author: s116730		e Date: 7/10/2024 3:22:25 PM
Aaa SW24-3(CA)	Assembly D(CA) imag	je	
Number: 17	Author: s116730	Subject: Text Box	Date: 7/10/2024 3:08:39 PM
			SW24-3(CA)

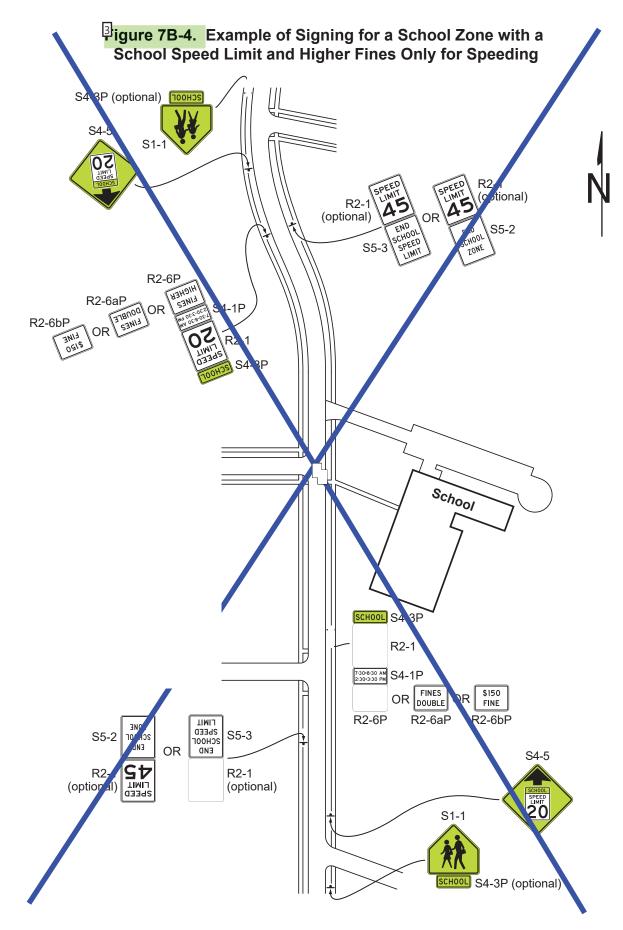


Number: 1	Author: s116730	Subject: Line	Date: 7/10/2024 3:16:43 PM
Number: 2	Author: s116730	Subject: Line	Date: 7/10/2024 3:16:27 PM

Mumber: 3 Author: s116730 Subject: Highlight Date: 7/25/2024 9:50:21 AM

NMUTCD 2023 changed NMUTCD 2009 Figure number 7B-3 to 7B-4 and made other minor changes in the figure. This figure was shown in CA MUTCD 2014R8 with a blue "X".

Since this figure is not applicable in CA, specific changes made in NMUTCD 2023 have not been identified.

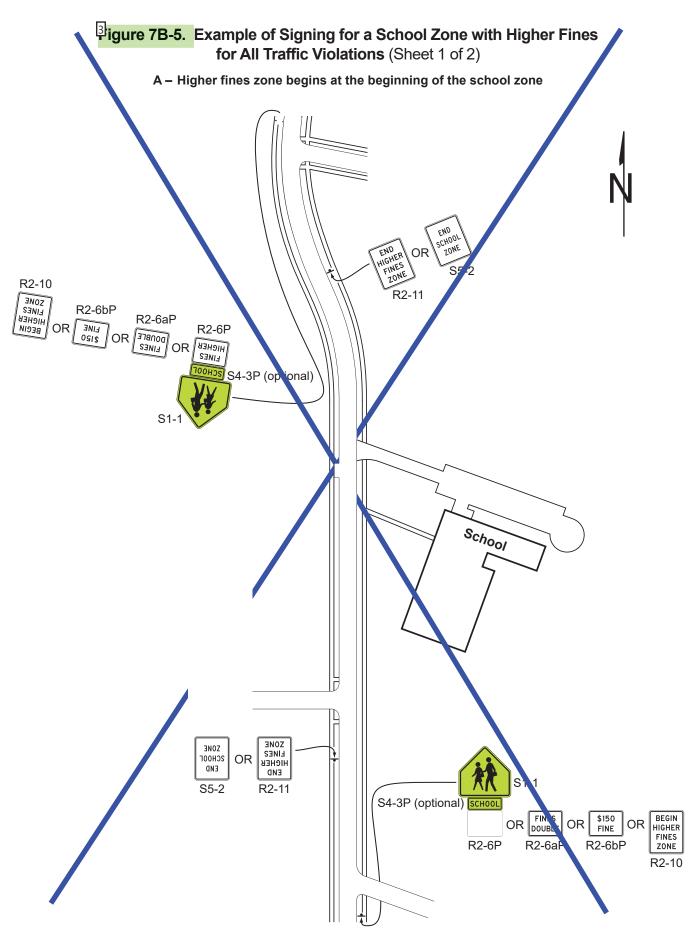


/Number: 1	Author: s116730	Subject: Line	Date: 7/10/2024 3:17:16 PM
,			
/Number: 2	Author: s116730	Subject: Line	Date: 7/10/2024 3:17:16 PM

Mumber: 3 Author: s116730 Subject: Highlight Date: 7/25/2024 9:50:27 AM

NMUTCD 2023 changed NMUTCD 2009 Figure number 7B-2 to 7B-5 (Sheets 1 and 2 of 2) and made other minor changes in the figure. NMUTCD 2023 Figure 7B-5(Sheet 1 of 2) is shown in CA MUTCD 2026 with a blue "X"

Since this figure is not applicable in CA, specific changes made in NMUTCD 2023 have not been identified.



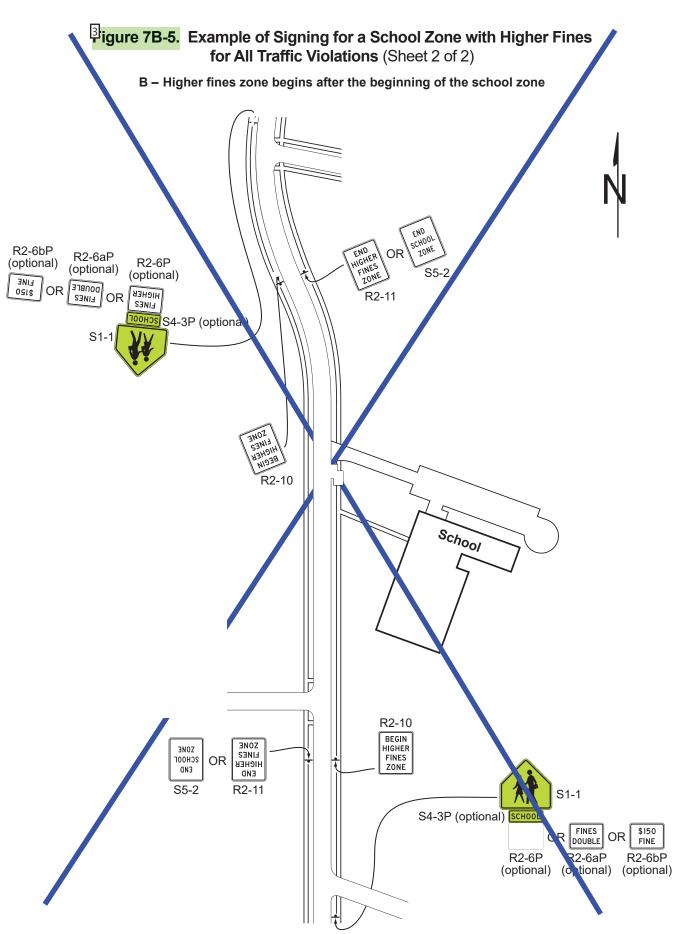


/Number: 1	Author: s116730	Subject: Line	Date: 7/10/2024 3:17:19 PM
,			
/Number: 2	Author: s116730	Subject: Line	Date: 7/10/2024 3:17:19 PM

Mumber: 3 Author: s116730 Subject: Highlight Date: 7/25/2024 9:50:31 AM


NMUTCD 2023 changed NMUTCD 2009 Figure number 7B-2 to 7B-5 (Sheet 1 and 2 of 2) and made other minor changes in the figure. NMUTCD 2023 Figure 7B-5(Sheet 2 of 2) is shown in CA MUTCD 2026 with a blue "X"

Since this figure is not applicable in CA, specific changes made in NMUTCD 2023 have not been identified.

Jigure 7B-101 (CA). Example of School Area Signs with Flashing Yellow Beacons

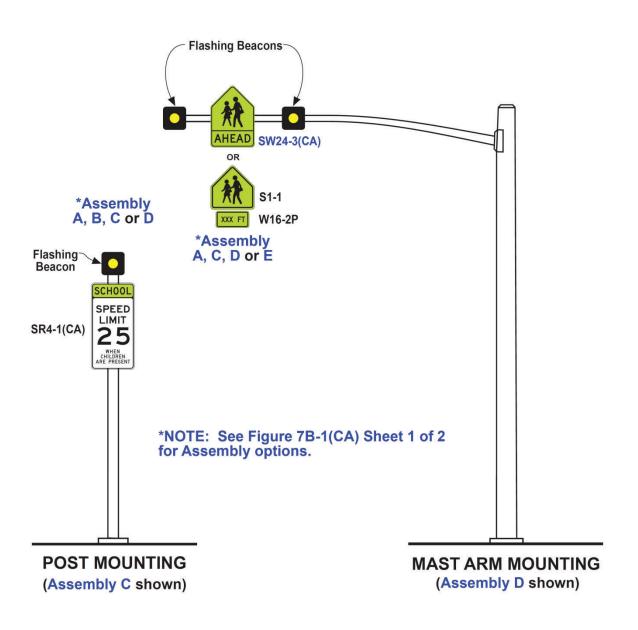


Number: 1 Author: s116730 Subject: Highlight Date: 7/25/2024 9:50:43 AM Figure 7B-101(CA) is included in CA MUTCD 2026.

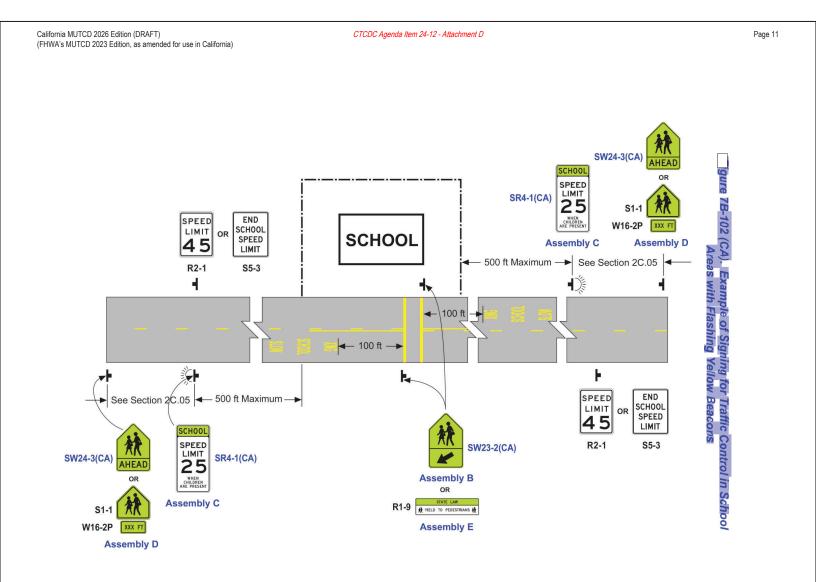


CTCDC Agenda Item 24-12 - Attachment D

Number: 1 Author: s116730 Subject: Highlight Date: 7/25/2024 9:50:47 AM Figure 7B-102(CA) is included in CA MUTCD 2026.

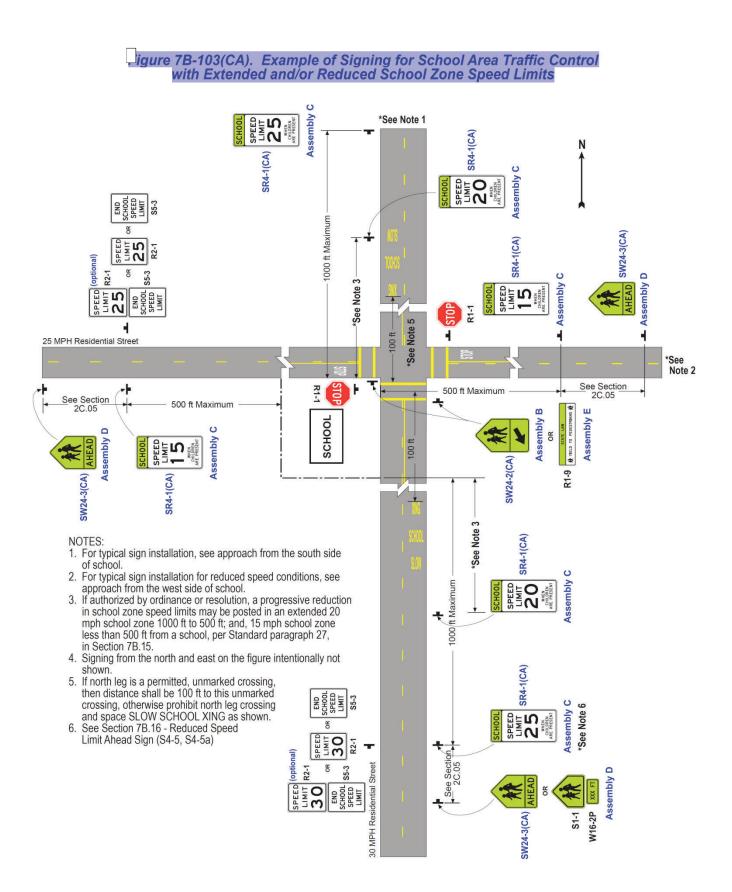

Number: 1 Author: s116730 Subject: Highlight Date: 7/25/2024 9:50:52 AM Figure 7B-103(CA) is included in CA MUTCD 2026. Jigure 7B-104(CA). Example of Signing for School Crosswalk Warning Assembly

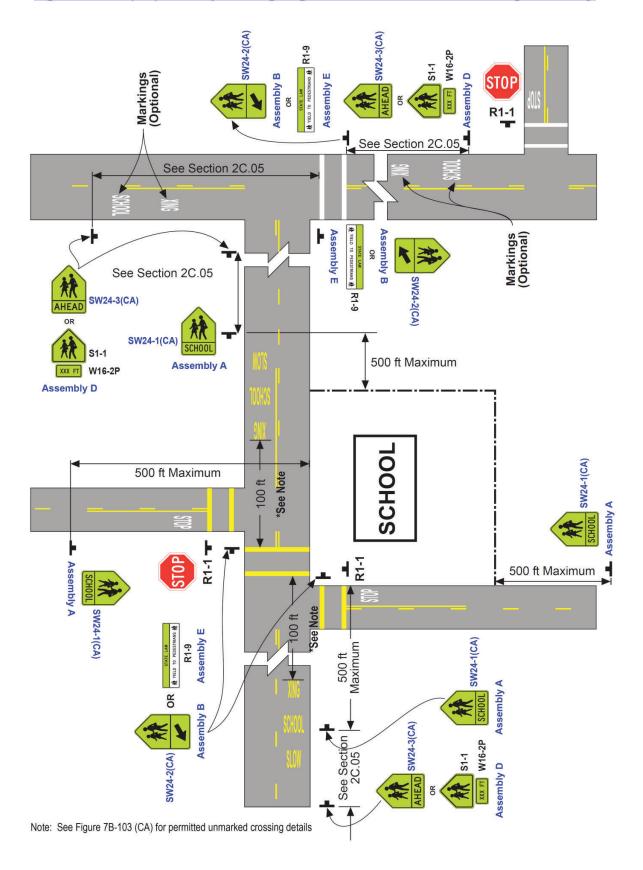

Number: 1 Author: s116730 Subject: Highlight Date: 7/25/2024 9:50:55 AM Figure 7B-101(CA) is included in CA MUTCD 2026.