


Figure 7A-1. Example of School Route Plan Map

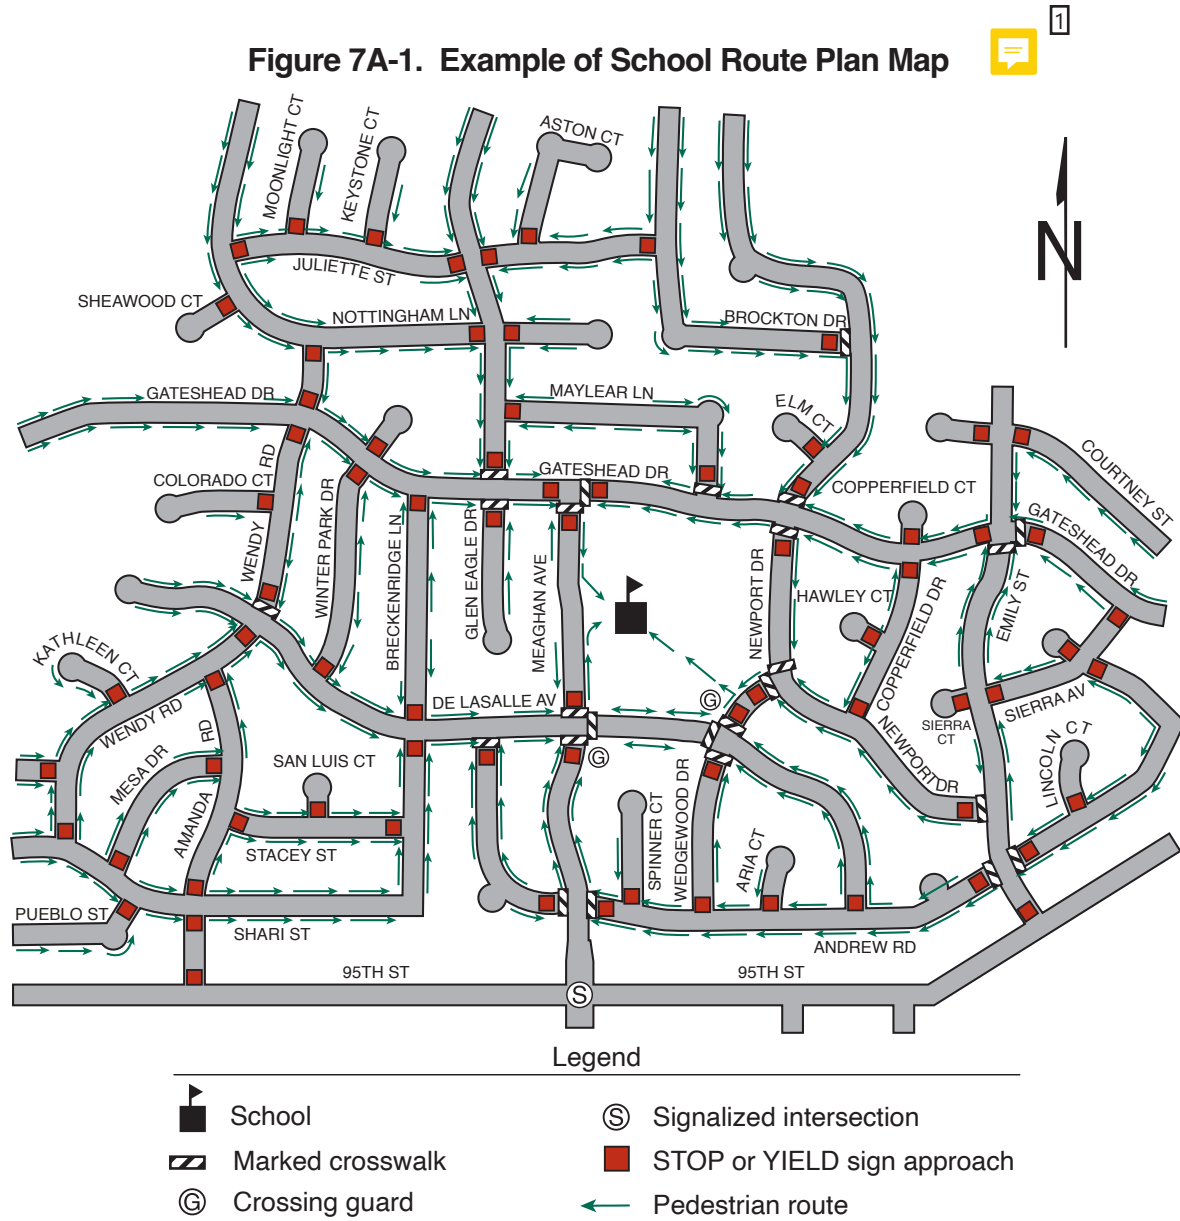

Summary of Comments on CAMUTCD 2026 7A Fig.pdf

Page: 1



Number: 1

Author: s116730


Subject: Sticky Note

Date: 7/16/2024 7:44:33 AM

No change in NMUTCD 2023 Figure, when comparing to CA MUTCD 2014R8 (NMUTCD 2009) Figure. This figure is included in CA MUTCD 2026.



Figure 7A-1. Example of School Route Plan Map

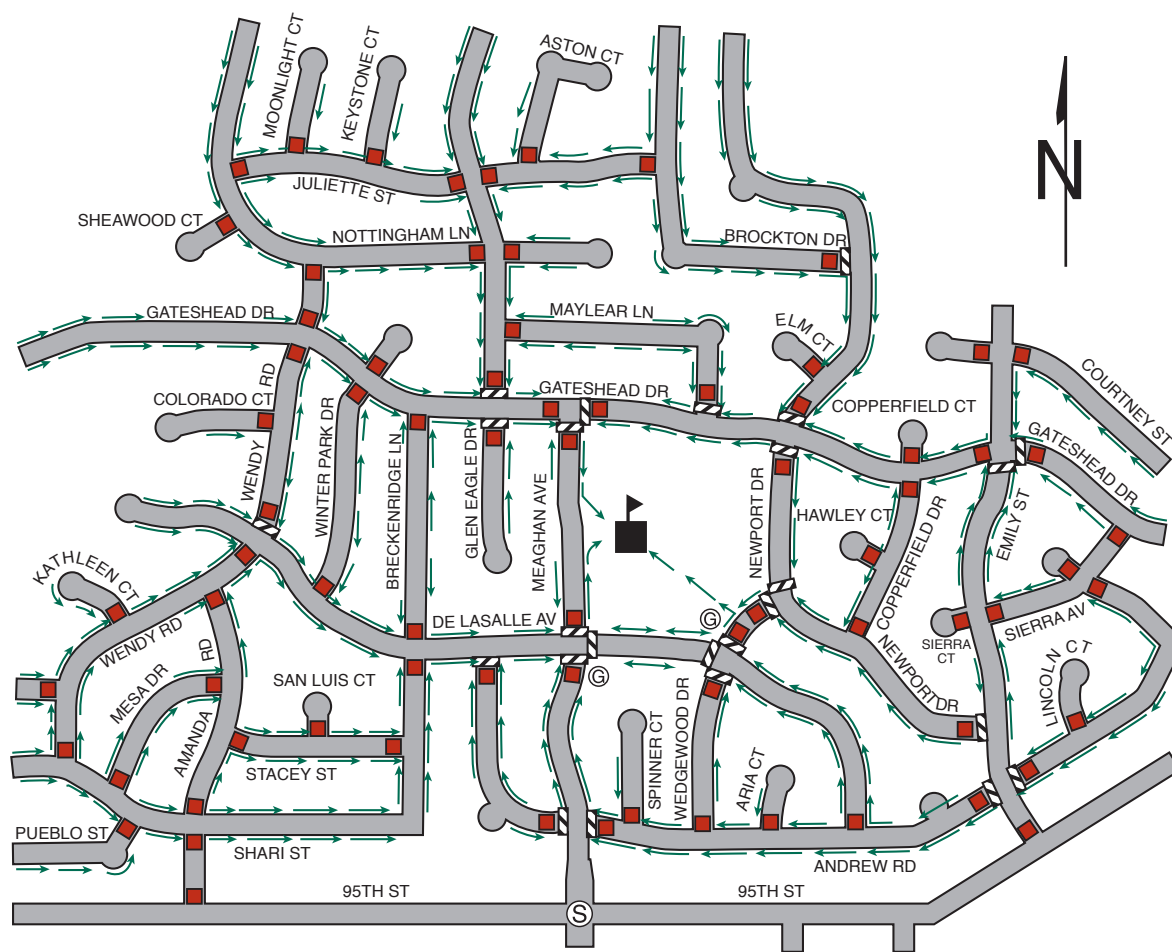

Legend

- | | |
|------------------|-----------------------------|
| School | Signalized intersection |
| Marked crosswalk | STOP or YIELD sign approach |
| Crossing guard | Pedestrian route |

Summary of Comments on Part 7A Figure CA MUTCD 2026

Page: 3

 Number: 1 Author: Johnny Bhullar Subject: Sticky Note Date: 3/27/2025 10:34:43 PM

Develop a new figure that will be added to Chapter 7A as Figure 7A-1 (Sheet 2 of 2) showing examples of all four legs of a four-leg intersection with marked crosswalks.