











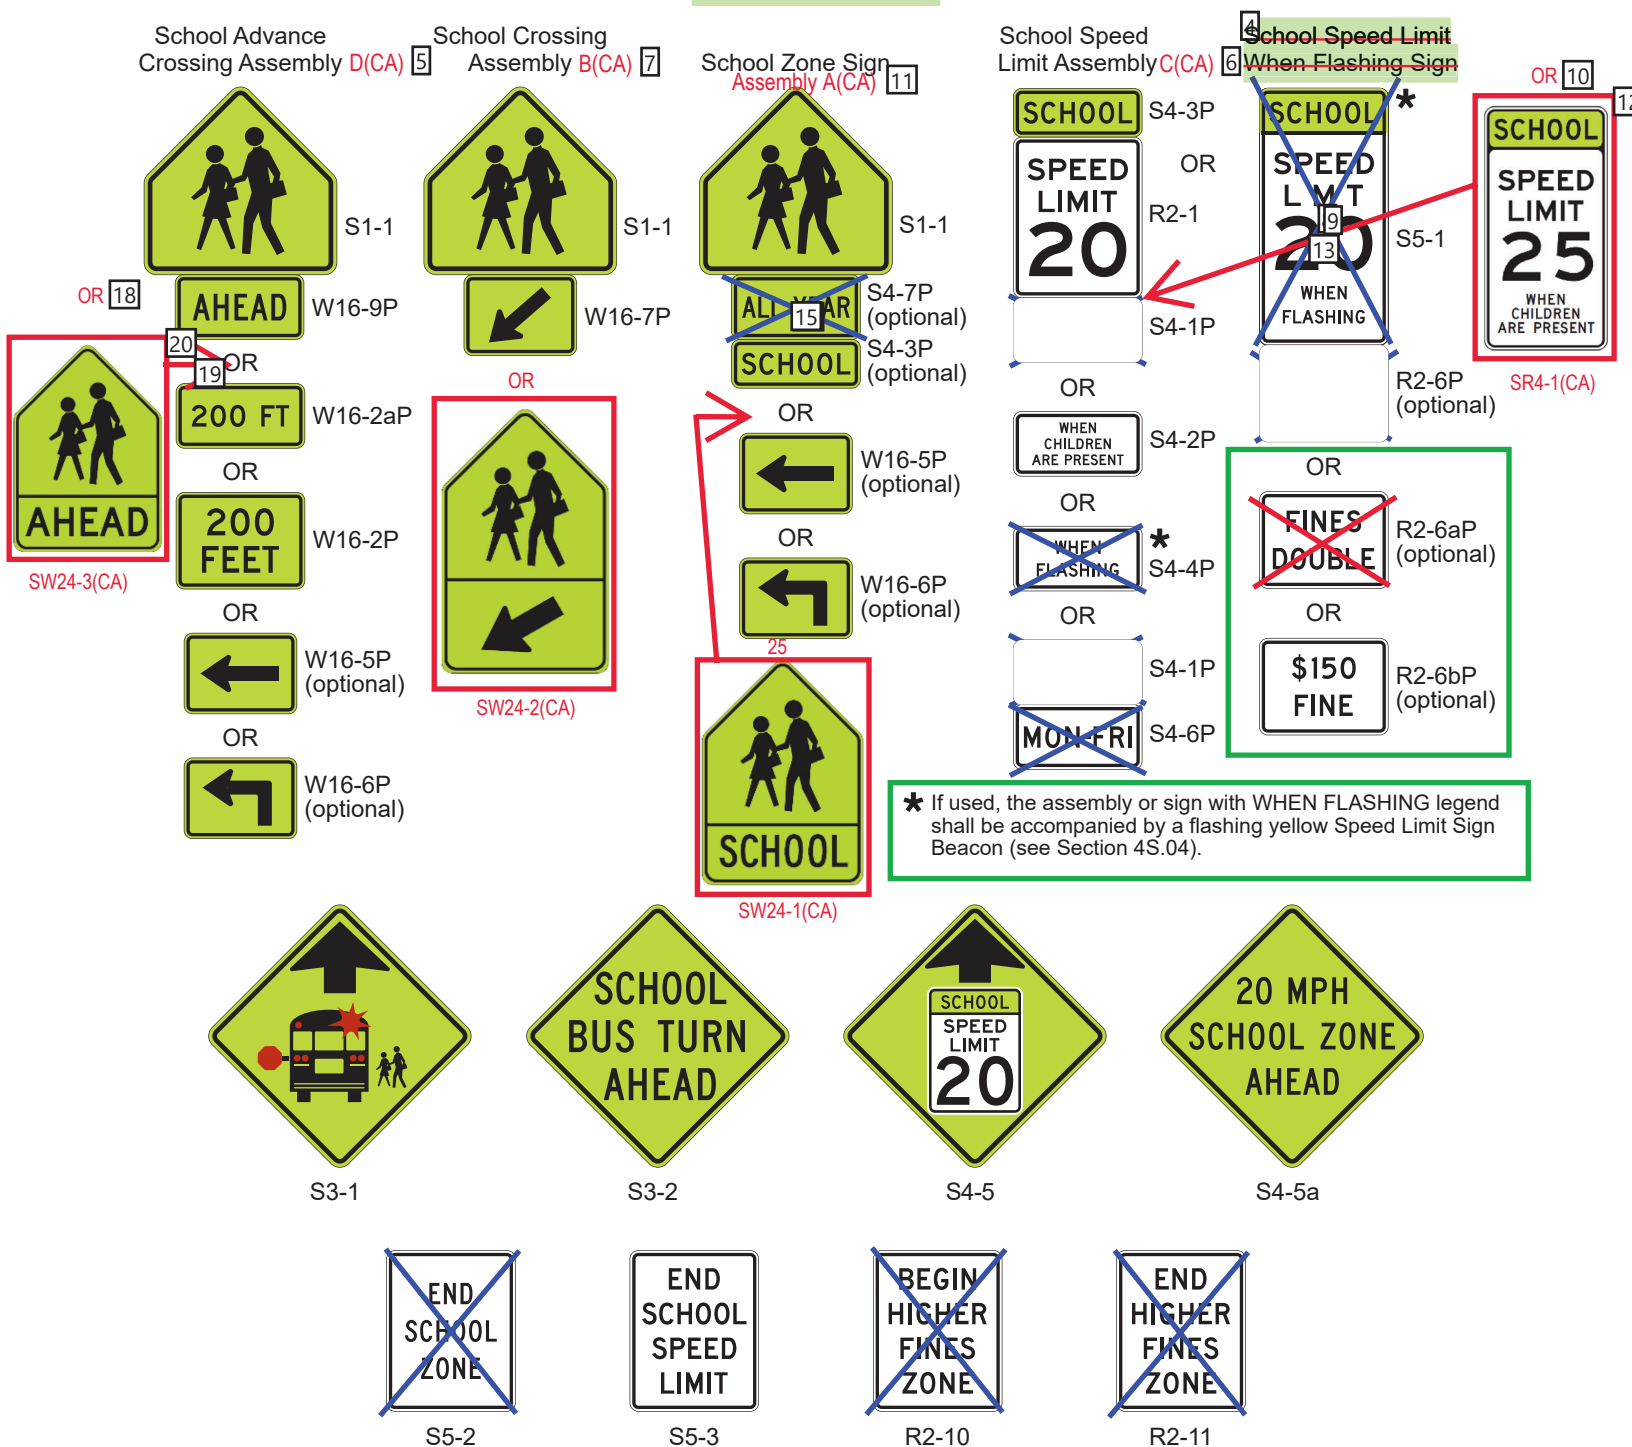







 




**Figure 7B-1. Signs in School Areas and at School Crossings** (Sheet 1 of 2)

 – School area signs



# Summary of Comments on CAMUTCD 2026 7B Fig.pdf


## Page: 1

	Number: 1	Author: s116730	Subject: Highlight	Date: 7/25/2024 9:46:00 AM
NMUTCD 2023 changed the title of Figure 7B-1 from "School Area Signs" to "Signs in School Areas and at School Crossings" and incorporated signs from NMUTCD 2009 Figures 7B-1 and 7B-6 and added sub-headings A thru D, expanding Figure 7B-1 into 2 sheets.				
NMUTCD 2023 added sign codes for all signs, which were missing in NMUTCD 2009 figures				
	Number: 2	Author: s116730	Subject: Highlight	Date: 7/25/2024 9:46:06 AM
NMUTCD 2023 added sub-heading A				
	Number: 3	Author: s116730	Subject: Cross-Out	Date: 7/8/2024 11:11:18 AM
	Number: 4	Author: s116730	Subject: Highlight	Date: 7/25/2024 9:46:13 AM
NMUTCD 2023 added new text				
	Number: 5	Author: s116730	Subject: Text Box	Date: 7/9/2024 3:32:56 PM
D(CA)				
	Number: 6	Author: s116730	Subject: Text Box	Date: 7/9/2024 4:02:20 PM
C(CA)				
	Number: 7	Author: s116730	Subject: Text Box	Date: 7/9/2024 3:33:04 PM
B(CA)				
	Number: 8	Author: s116730	Subject: Line	Date: 7/8/2024 11:10:57 AM
	Number: 9	Author: s116730	Subject: Line	Date: 7/8/2024 11:11:04 AM
	Number: 10	Author: s116730	Subject: Text Box	Date: 7/9/2024 4:04:35 PM
OR				
	Number: 11	Author: s116730	Subject: Text Box	Date: 7/9/2024 4:13:49 PM
Assembly A(CA)				
	Number: 12	Author: s116730	Subject: Rectangle	Date: 7/9/2024 4:03:24 PM
Add SR4-1(CA) image in Assembly C(CA) between the R2-1 and S4-1P				
	Number: 13	Author: s116730	Subject: Line	Date: 7/9/2024 4:06:01 PM
	Number: 14	Author: s116730	Subject: Line	Date: 7/8/2024 10:52:49 AM
	Number: 15	Author: s116730	Subject: Line	Date: 7/8/2024 10:53:42 AM
	Number: 16	Author: s116730	Subject: Line	Date: 7/8/2024 10:57:59 AM
	Number: 17	Author: s116730	Subject: Line	Date: 7/8/2024 10:57:59 AM
	Number: 18	Author: s116730	Subject: Text Box	Date: 7/9/2024 3:56:43 PM
OR				
	Number: 19	Author: s116730	Subject: Line	Date: 7/9/2024 4:08:27 PM
	Number: 20	Author: s116730	Subject: Rectangle	Date: 7/9/2024 3:56:19 PM
Add SW24-3(CA) image in Assembly D(CA) between the W16-9P and W16-2aP				
	Number: 21	Author: s116730	Subject: Line	Date: 7/8/2024 11:12:25 AM
	Number: 22	Author: s116730	Subject: Line	Date: 7/8/2024 11:12:17 AM

Comments from page 1 continued on next page

**Figure 7B-1. Signs in School Areas and at School Crossings (Sheet 1 of 2)**

**A – School area signs**

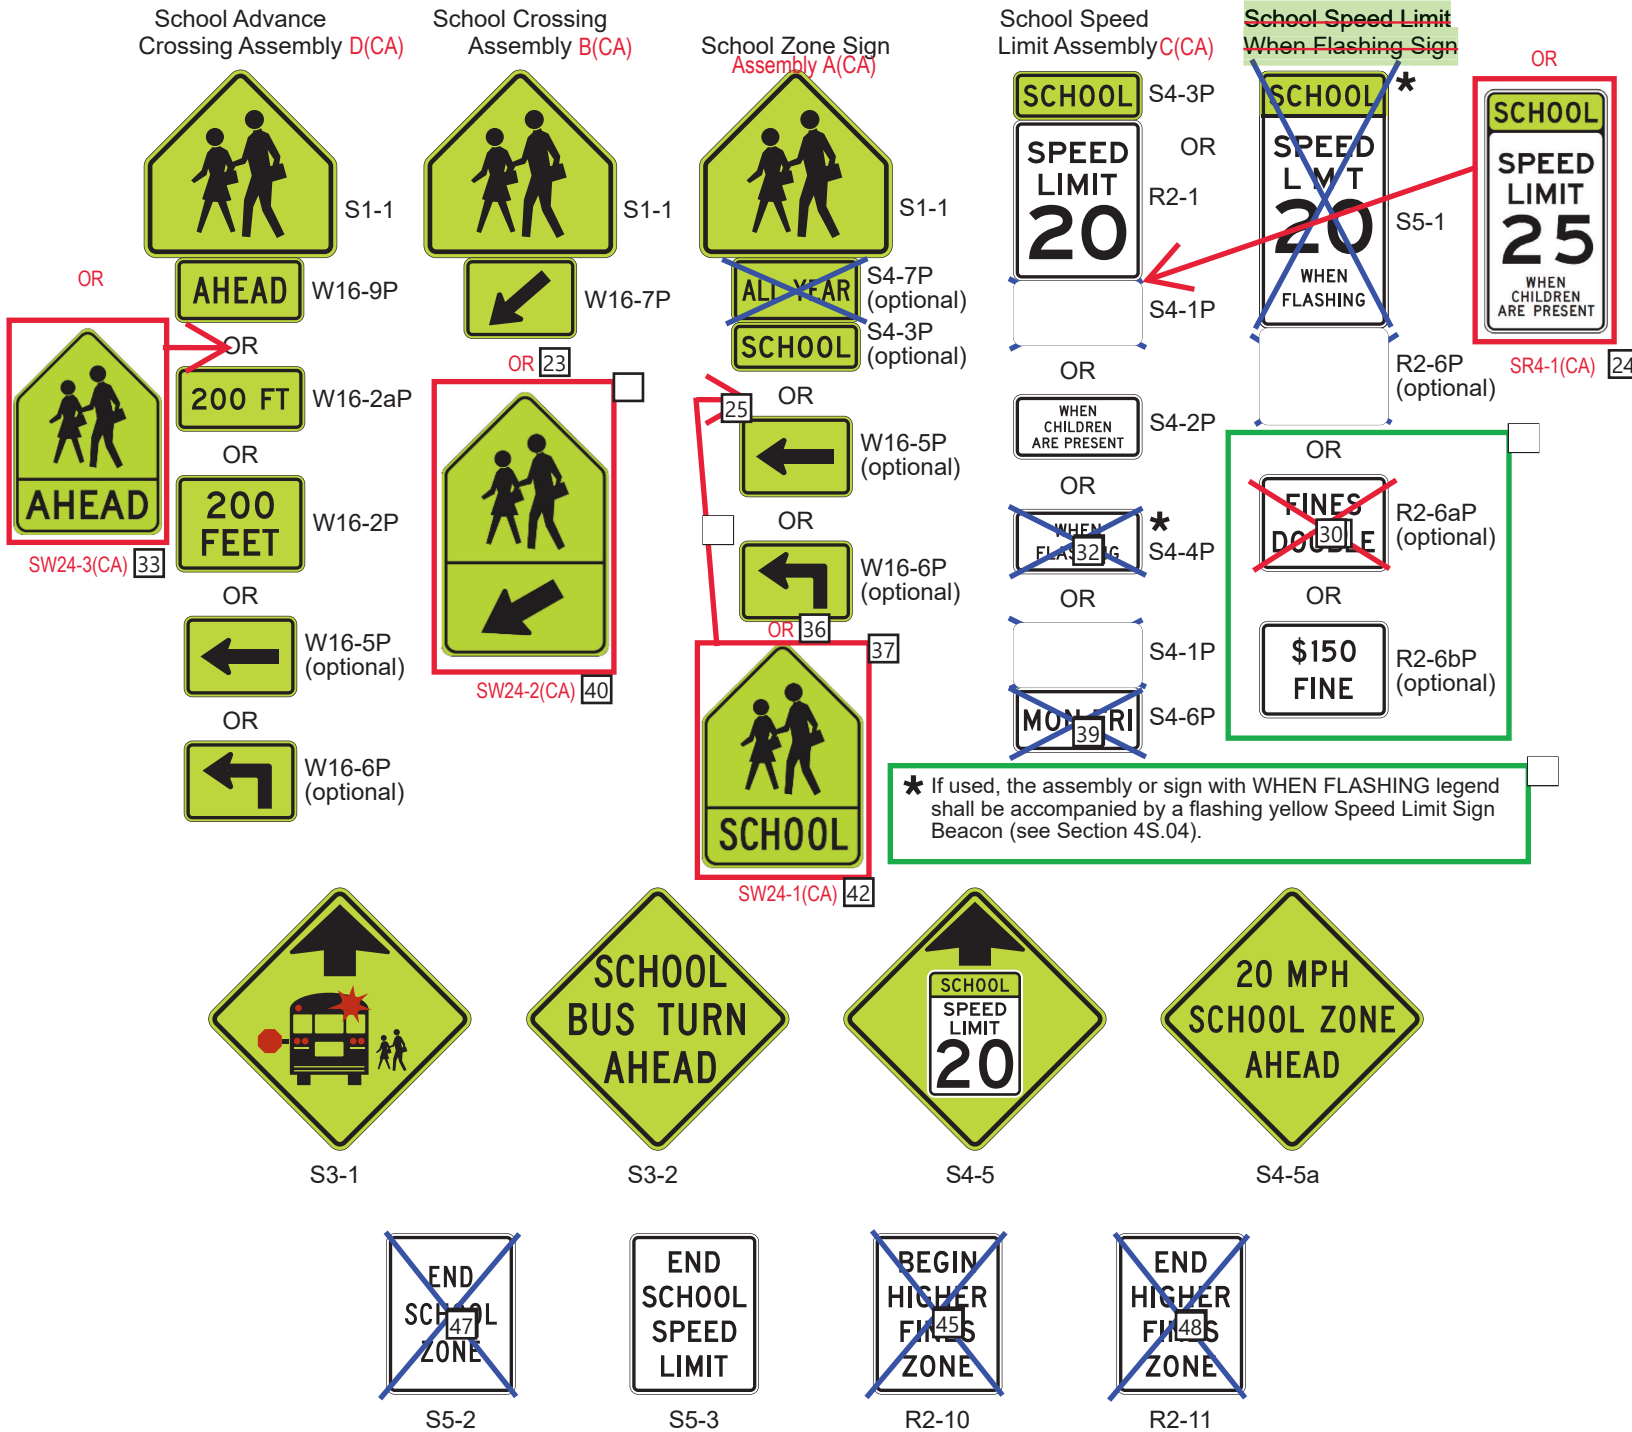


	Number: 23	Author: s116730	Subject: Text Box	Date: 7/9/2024 3:57:09 PM
OR				
	Number: 24	Author: s116730	Subject: Text Box	Date: 7/9/2024 4:04:01 PM
SR4-1(CA)				
	Number: 25	Author: s116730	Subject: Line	Date: 7/9/2024 4:07:36 PM
	Number: 26	Author: s116730	Subject: Rectangle	Date: 7/9/2024 3:59:42 PM
Add SW24-2(CA) image in Assembly D(CA) below the W16-7P				
	Number: 27	Author: s116730	Subject: Line	Date: 7/9/2024 4:06:50 PM
	Number: 28	Author: s116730	Subject: Rectangle	Date: 7/13/2024 10:03:54 AM
NMUTCD 2023 added new signs				
	Number: 29	Author: s116730	Subject: Line	Date: 7/8/2024 11:16:39 AM
	Number: 30	Author: s116730	Subject: Line	Date: 7/8/2024 11:16:39 AM
	Number: 31	Author: s116730	Subject: Line	Date: 7/8/2024 10:57:28 AM
	Number: 32	Author: s116730	Subject: Line	Date: 7/8/2024 10:57:13 AM
	Number: 33	Author: s116730	Subject: Text Box	Date: 7/9/2024 3:56:26 PM
SW24-3(CA)				
	Number: 34	Author: s116730	Subject: Line	Date: 7/8/2024 10:58:34 AM
	Number: 35	Author: s116730	Subject: Line	Date: 7/8/2024 10:58:34 AM
	Number: 36	Author: s116730	Subject: Text Box	Date: 7/9/2024 3:57:52 PM
OR				
	Number: 37	Author: s116730	Subject: Rectangle	Date: 7/9/2024 3:47:20 PM
Add SW24-1(CA) image in Assembly A(CA) between the S4-3P and W16-5P				
	Number: 38	Author: s116730	Subject: Line	Date: 7/8/2024 10:58:51 AM
	Number: 39	Author: s116730	Subject: Line	Date: 7/8/2024 10:58:51 AM
	Number: 40	Author: s116730	Subject: Text Box	Date: 7/9/2024 3:58:56 PM
SW24-2(CA)				
	Number: 41	Author: s116730	Subject: Rectangle	Date: 7/13/2024 10:04:44 AM
NMUTCD 2023 added new note				
	Number: 42	Author: s116730	Subject: Text Box	Date: 7/9/2024 3:57:21 PM
SW24-1(CA)				
	Number: 43	Author: s116730	Subject: Line	Date: 7/8/2024 11:13:52 AM
	Number: 44	Author: s116730	Subject: Line	Date: 7/8/2024 11:13:18 AM
	Number: 45	Author: s116730	Subject: Line	Date: 7/8/2024 11:13:52 AM
	Number: 46	Author: s116730	Subject: Line	Date: 7/8/2024 11:14:21 AM
	Number: 47	Author: s116730	Subject: Line	Date: 7/8/2024 11:13:30 AM
	Number: 48	Author: s116730	Subject: Line	Date: 7/8/2024 11:14:21 AM

Comments from page 1 continued on next page

**Figure 7B-1. Signs in School Areas and at School Crossings (Sheet 1 of 2)**

**A – School area signs**

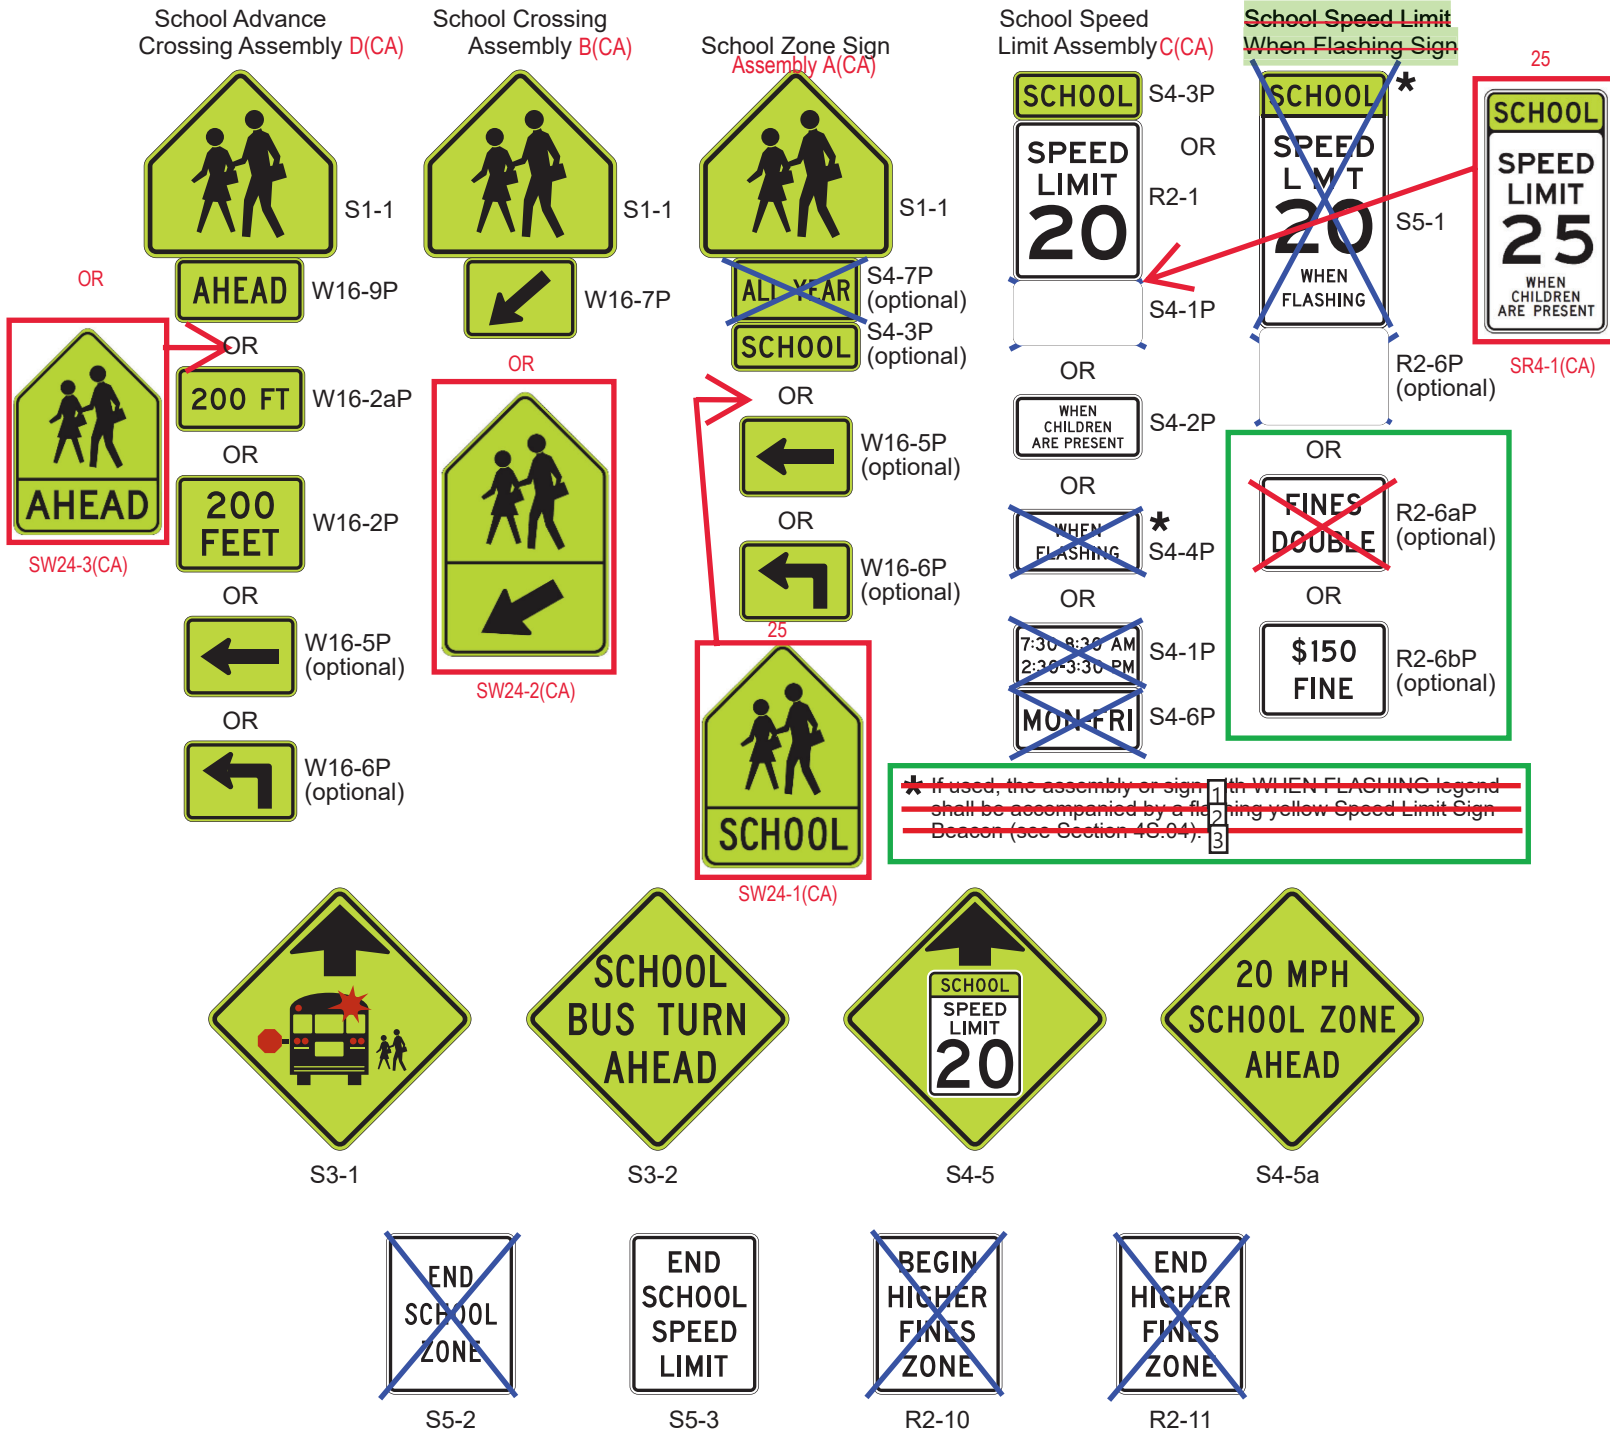

# Summary of Comments on Part 7B Figure CA MUTCD 2026


Page: 5

Number: 1	Author: Johnny Bhullar	Subject: Line	Date: 3/28/2025 10:09:50 AM
Number: 2	Author: Johnny Bhullar	Subject: Line	Date: 3/28/2025 10:10:09 AM
Number: 3	Author: Johnny Bhullar	Subject: Line	Date: 3/28/2025 10:10:20 AM




**Figure 7B-1. Signs in School Areas and at School Crossings** (Sheet 2 of 2)


**2 – Signs in advance of the school crossing**

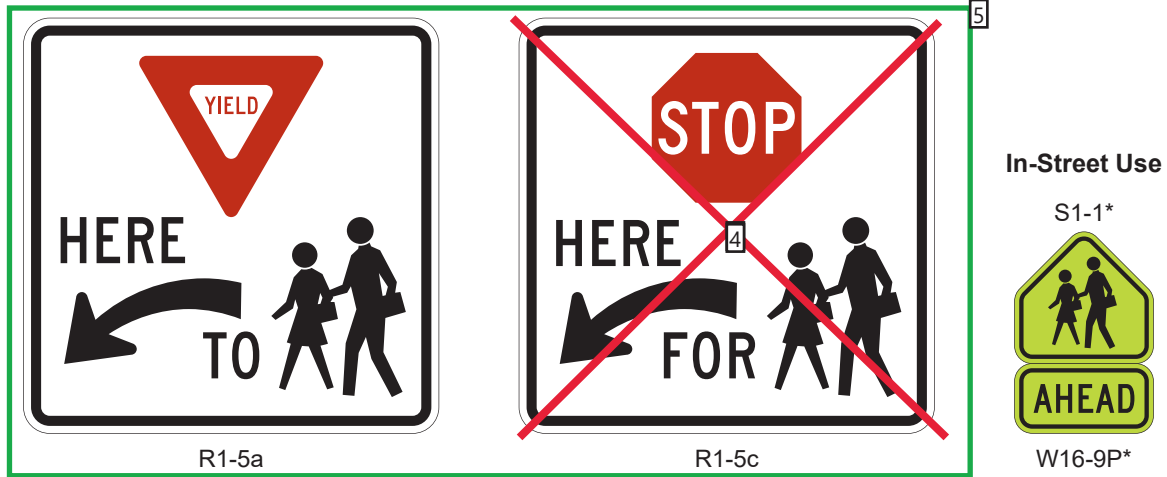

**6 – In-street signs at the school crossing**

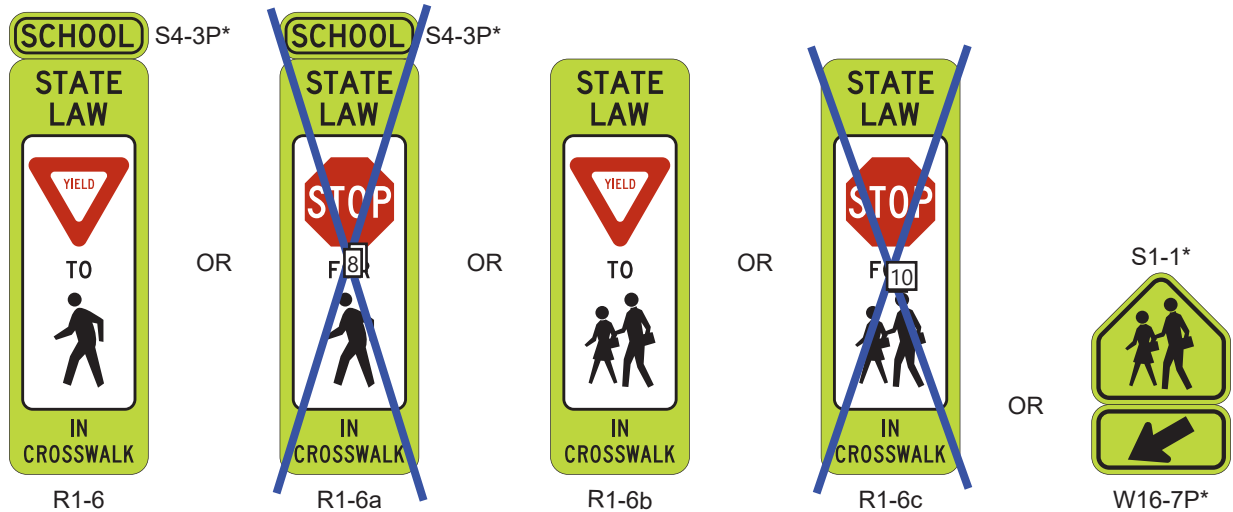

**11 – Overhead signs at the school crossing** Assembly E(CA)

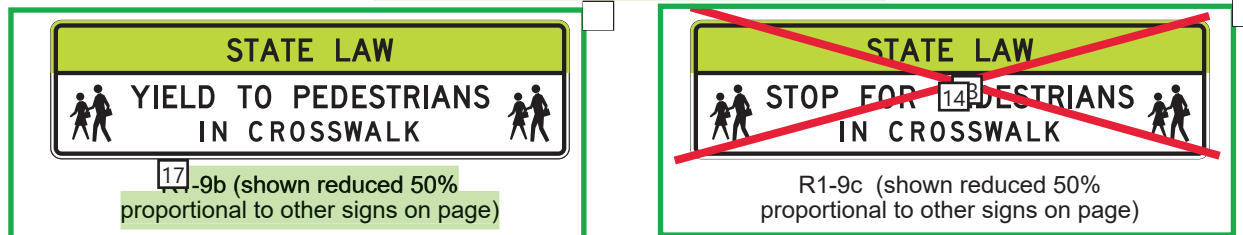

Notes:





















1. The use of the STATE LAW legend is optional on the R1-6 series and R1-9 series signs (see Section 7B.03).
2. The use of the SCHOOL plaque above the R1-6 and R1-6a signs is optional.
3. Signs are shown in proportion to their designated sizes unless otherwise noted.

\*Reduced size signs in-street use (see Section 7B.03):


S1-1	12 x 12 inches
S4-3P	12 x 4 inches
W16-7P	12 x 6 inches
W16-9P	12 x 6 inches



## Page: 2

	Number: 1	Author: s116730	Subject: Highlight	Date: 7/25/2024 9:46:47 AM
NMUTCD 2023 changed the title of Figure 7B-1 from "School Area Signs" to "Signs in School Areas and at School Crossings" and incorporated signs from NMUTCD 2009 Figures 7B-1 and 7B-6 and added sub-headings A thru D, expanding Figure 7B-1 into 2 sheets.				
NMUTCD 2023 added sign codes for all signs, which were missing in NMUTCD 2009 figures				
	Number: 2	Author: s116730	Subject: Highlight	Date: 7/25/2024 9:46:51 AM
NMUTCD 2023 changed sub-heading A in NMUTCD 2009 Figure 7B-6 to B				
	Number: 3	Author: s116730	Subject: Line	Date: 7/10/2024 8:44:02 AM
	Number: 4	Author: s116730	Subject: Line	Date: 7/10/2024 8:44:02 AM
	Number: 5	Author: s116730	Subject: Rectangle	Date: 7/13/2024 10:07:09 AM
NMUTCD 2023 added new signs				
	Number: 6	Author: s116730	Subject: Highlight	Date: 7/25/2024 9:47:03 AM
NMUTCD 2023 changed sub-heading B in NMUTCD 2009 Figure 7B-6 to C				
	Number: 7	Author: s116730	Subject: Line	Date: 7/14/2024 8:17:45 AM
	Number: 8	Author: s116730	Subject: Line	Date: 7/14/2024 8:17:45 AM
	Number: 9	Author: s116730	Subject: Line	Date: 7/14/2024 8:17:45 AM
	Number: 10	Author: s116730	Subject: Line	Date: 7/14/2024 8:17:45 AM
	Number: 11	Author: s116730	Subject: Highlight	Date: 7/25/2024 9:47:07 AM
NMUTCD 2023 added sub-heading D				
	Number: 12	Author: s116730	Subject: Text Box	Date: 7/9/2024 4:12:53 PM
Assembly E(CA)				
	Number: 13	Author: s116730	Subject: Line	Date: 7/10/2024 8:46:35 AM
	Number: 14	Author: s116730	Subject: Line	Date: 7/10/2024 8:46:24 AM
	Number: 15	Author: s116730	Subject: Rectangle	Date: 7/13/2024 10:07:36 AM
NMUTCD 2023 added new signs				
	Number: 16	Author: s116730	Subject: Rectangle	Date: 7/13/2024 10:07:27 AM
NMUTCD 2023 added text "IN CROSSWALK" as 3rd line in the sign				
	Number: 17	Author: s116730	Subject: Highlight	Date: 7/25/2024 9:47:24 AM
NMUTCD 2023 changed sign code from R1-9 in NMUTCD 2009 to R1-9b and added this text description.				
	Number: 18	Author: s116730	Subject: Highlight	Date: 7/25/2024 9:47:33 AM
	Number: 19	Author: s116730	Subject: Highlight	Date: 7/25/2024 9:47:28 AM
NMUTCD 2023 added this text in the Note #1. Note #1 previously was in NMUTCD 2009 Figure 7B-6.				
	Number: 20	Author: s116730	Subject: Highlight	Date: 7/25/2024 9:47:38 AM
NMUTCD 2023 added new note				

~~Figure 7B-1(CA). School Area Signs (Sheet 2 of 2)~~  
**Figure 7B-1(CA). Signs in School Areas and at School Crossings**

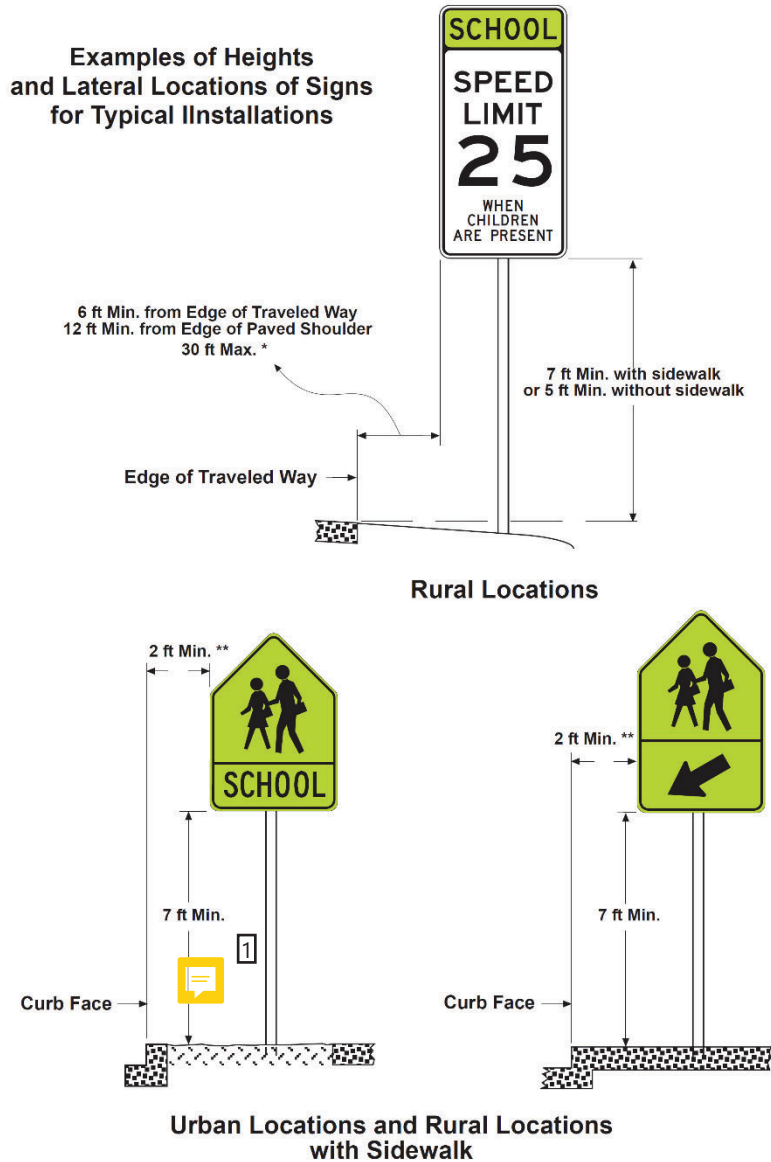


**NOTES:**

- (\*) When clear roadside recovery areas are provided, signs shall be placed as far from the edge of traveled way as possible, up to a maximum of 30 ft. When possible they shall be placed in locations less likely to be hit by a vehicle leaving the traveled way. Signs should not be closer than 6 ft from the edge of a paved shoulder, or if none, 12 ft from the edge of the traveled way.
- (\*\*) In urban areas, where sidewalk width is limited or existing poles are close to the curb, a clearance of 1 ft from the curb face is permissible.


---

 Number: 1      Author: Johnny Bhullar      Subject: Sticky Note      Date: 3/28/2025 10:00:10 AM


---

 Author: Johnny Bhullar      Subject: Sticky Note      Date: 3/28/2025 10:05:44 AM  
Revise single line text "7 ft. Min." to two line text, with 1st line as "7 ft. Min. (Urban)" and second line as "5 ft. Min. (Rural)"

---


 Number: 2      Author: Johnny Bhullar      Subject: Sticky Note      Date: 3/28/2025 9:57:22 AM

---

 Author: Johnny Bhullar      Subject: Sticky Note      Date: 3/28/2025 9:58:53 AM  
Add Note:  
"A 4-foot minimum unobstructed pedestrian access route should be maintained."

---

---


 Number: 1      Author: s116730      Subject: Sticky Note      Date: 7/16/2024 7:58:04 AM  
Figure name changed to match NMUTCD 2023 Figure 7B-1 name and text for "(Sheet 2 of 2)" is deleted.

---


This figure is included in CA MUTCD 2026.

 Number: 2      Author: s116730      Subject: Cross-Out      Date: 7/10/2024 8:41:50 AM

---


 Number: 3      Author: s116730      Subject: Cross-Out      Date: 7/25/2024 9:48:03 AM  
NMUTCD 2023 changed the title of Figure 7B-1 from "School Area Signs" to "Signs in School Areas and at School Crossings"


---

 Number: 4      Author: s116730      Subject: Text Box      Date: 7/25/2024 9:48:13 AM  
**Figure 7B-1(CA). Signs in School Areas and at School Crossings**


---

**Figure 7B-2. Example of Signing for a School Zone with a School Speed Limit and a School Crossing**

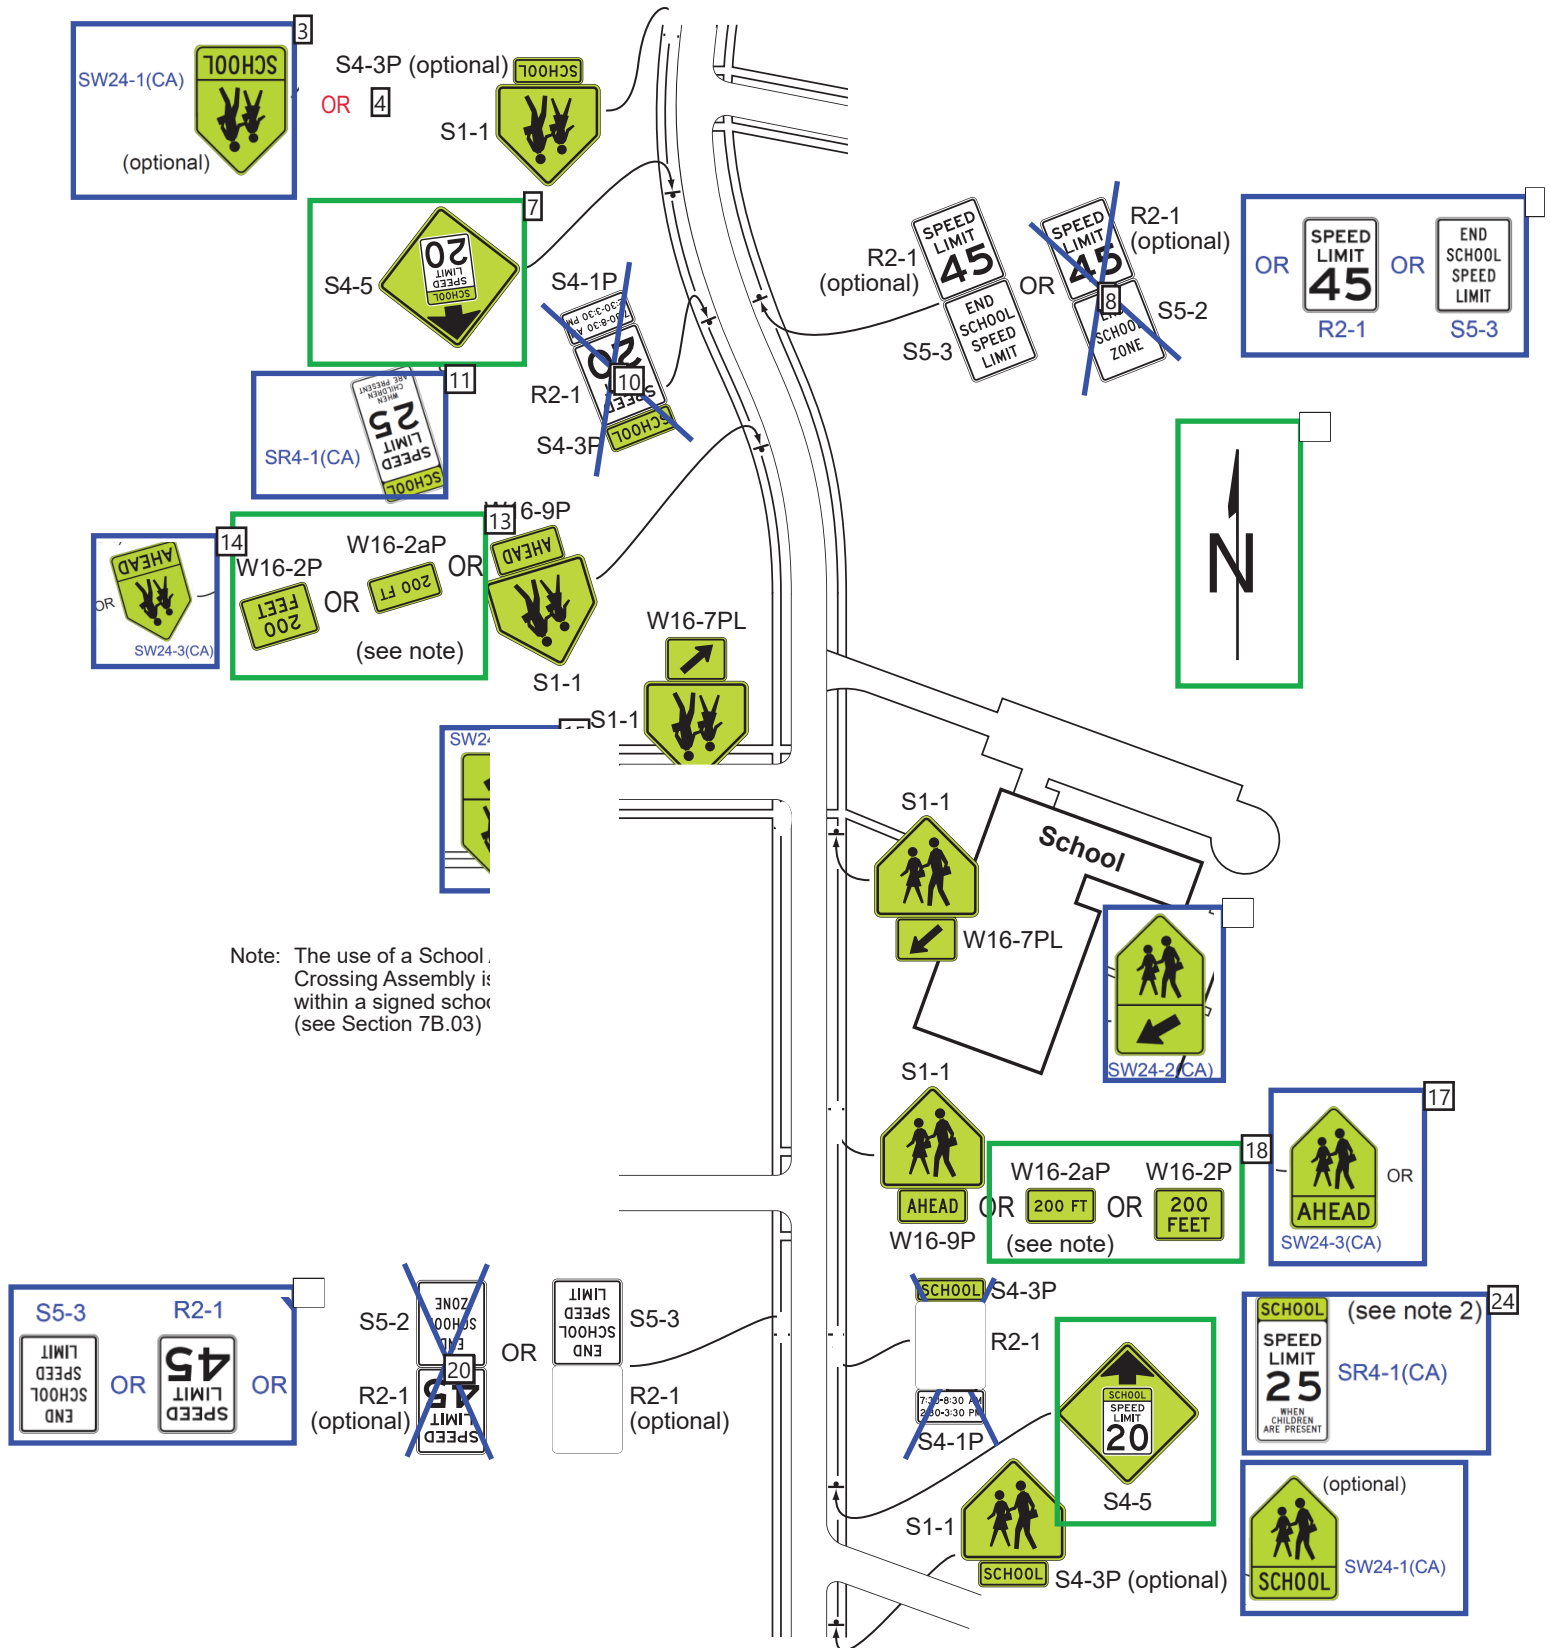

	Number: 1	Author: s116730	Subject: Highlight	Date: 7/25/2024 9:48:20 AM
NMUTCD 2023 added sign codes for all signs, which were missing in NMUTCD 2009 figures				
	Number: 2	Author: s116730	Subject: Highlight	Date: 7/25/2024 9:48:24 AM
NMUTCD 2023 changed NMUTCD 2009 Figure 7B-5 to 7B-2 and added sign codes for the signs shown in the figure.				
	Number: 3	Author: s116730	Subject: Rectangle	Date: 7/10/2024 9:45:30 AM
Incorporated from CA MUTCD 2014R8 Figure 7B-5				
	Number: 4	Author: s116730	Subject: Text Box	Date: 7/10/2024 9:43:42 AM
OR				
	Number: 5	Author: s116730	Subject: Line	Date: 7/10/2024 9:37:58 AM
	Number: 6	Author: s116730	Subject: Rectangle	Date: 7/10/2024 9:55:06 AM
Incorporated from CA MUTCD 2014R8 Figure 7B-5				
	Number: 7	Author: s116730	Subject: Rectangle	Date: 7/14/2024 8:38:40 AM
NMUTCD 2023 added new sign				
	Number: 8	Author: s116730	Subject: Line	Date: 7/10/2024 9:37:47 AM
	Number: 9	Author: s116730	Subject: Line	Date: 7/10/2024 9:38:20 AM
	Number: 10	Author: s116730	Subject: Line	Date: 7/10/2024 9:38:20 AM
	Number: 11	Author: s116730	Subject: Rectangle	Date: 7/10/2024 9:55:55 AM
Incorporated from CA MUTCD 2014R8 Figure 7B-5				
	Number: 12	Author: s116730	Subject: Rectangle	Date: 7/14/2024 8:40:44 AM
NMUTCD 2023 added new cardinal direction "N" arrow				
	Number: 13	Author: s116730	Subject: Rectangle	Date: 7/13/2024 10:10:07 AM
NMUTCD 2023 added new plaques				
	Number: 14	Author: s116730	Subject: Rectangle	Date: 7/10/2024 2:53:25 PM
Incorporated from CA MUTCD 2014R8 Figure 7B-5				
	Number: 15	Author: s116730	Subject: Rectangle	Date: 7/10/2024 2:34:53 PM
Incorporated from CA MUTCD 2014R8 Figure 7B-5				
	Number: 16	Author: s116730	Subject: Rectangle	Date: 7/10/2024 2:35:20 PM
Incorporated from CA MUTCD 2014R8 Figure 7B-5				
	Number: 17	Author: s116730	Subject: Rectangle	Date: 7/10/2024 9:56:34 AM
Incorporated from CA MUTCD 2014R8 Figure 7B-5				
	Number: 18	Author: s116730	Subject: Rectangle	Date: 7/13/2024 10:10:21 AM
NMUTCD 2023 added new plaques				
	Number: 19	Author: s116730	Subject: Line	Date: 7/10/2024 9:51:04 AM
	Number: 20	Author: s116730	Subject: Line	Date: 7/10/2024 9:50:49 AM
	Number: 21	Author: s116730	Subject: Line	Date: 7/10/2024 9:40:05 AM
	Number: 22	Author: s116730	Subject: Line	Date: 7/10/2024 9:39:53 AM
	Number: 23	Author: s116730	Subject: Rectangle	Date: 7/10/2024 9:56:16 AM
Incorporated from CA MUTCD 2014R8 Figure 7B-5				
	Number: 24	Author: s116730	Subject: Rectangle	Date: 7/10/2024 9:57:20 AM

**Figure 7B-2. Example of Signing for a School Zone with a School Speed Limit and a School Crossing**

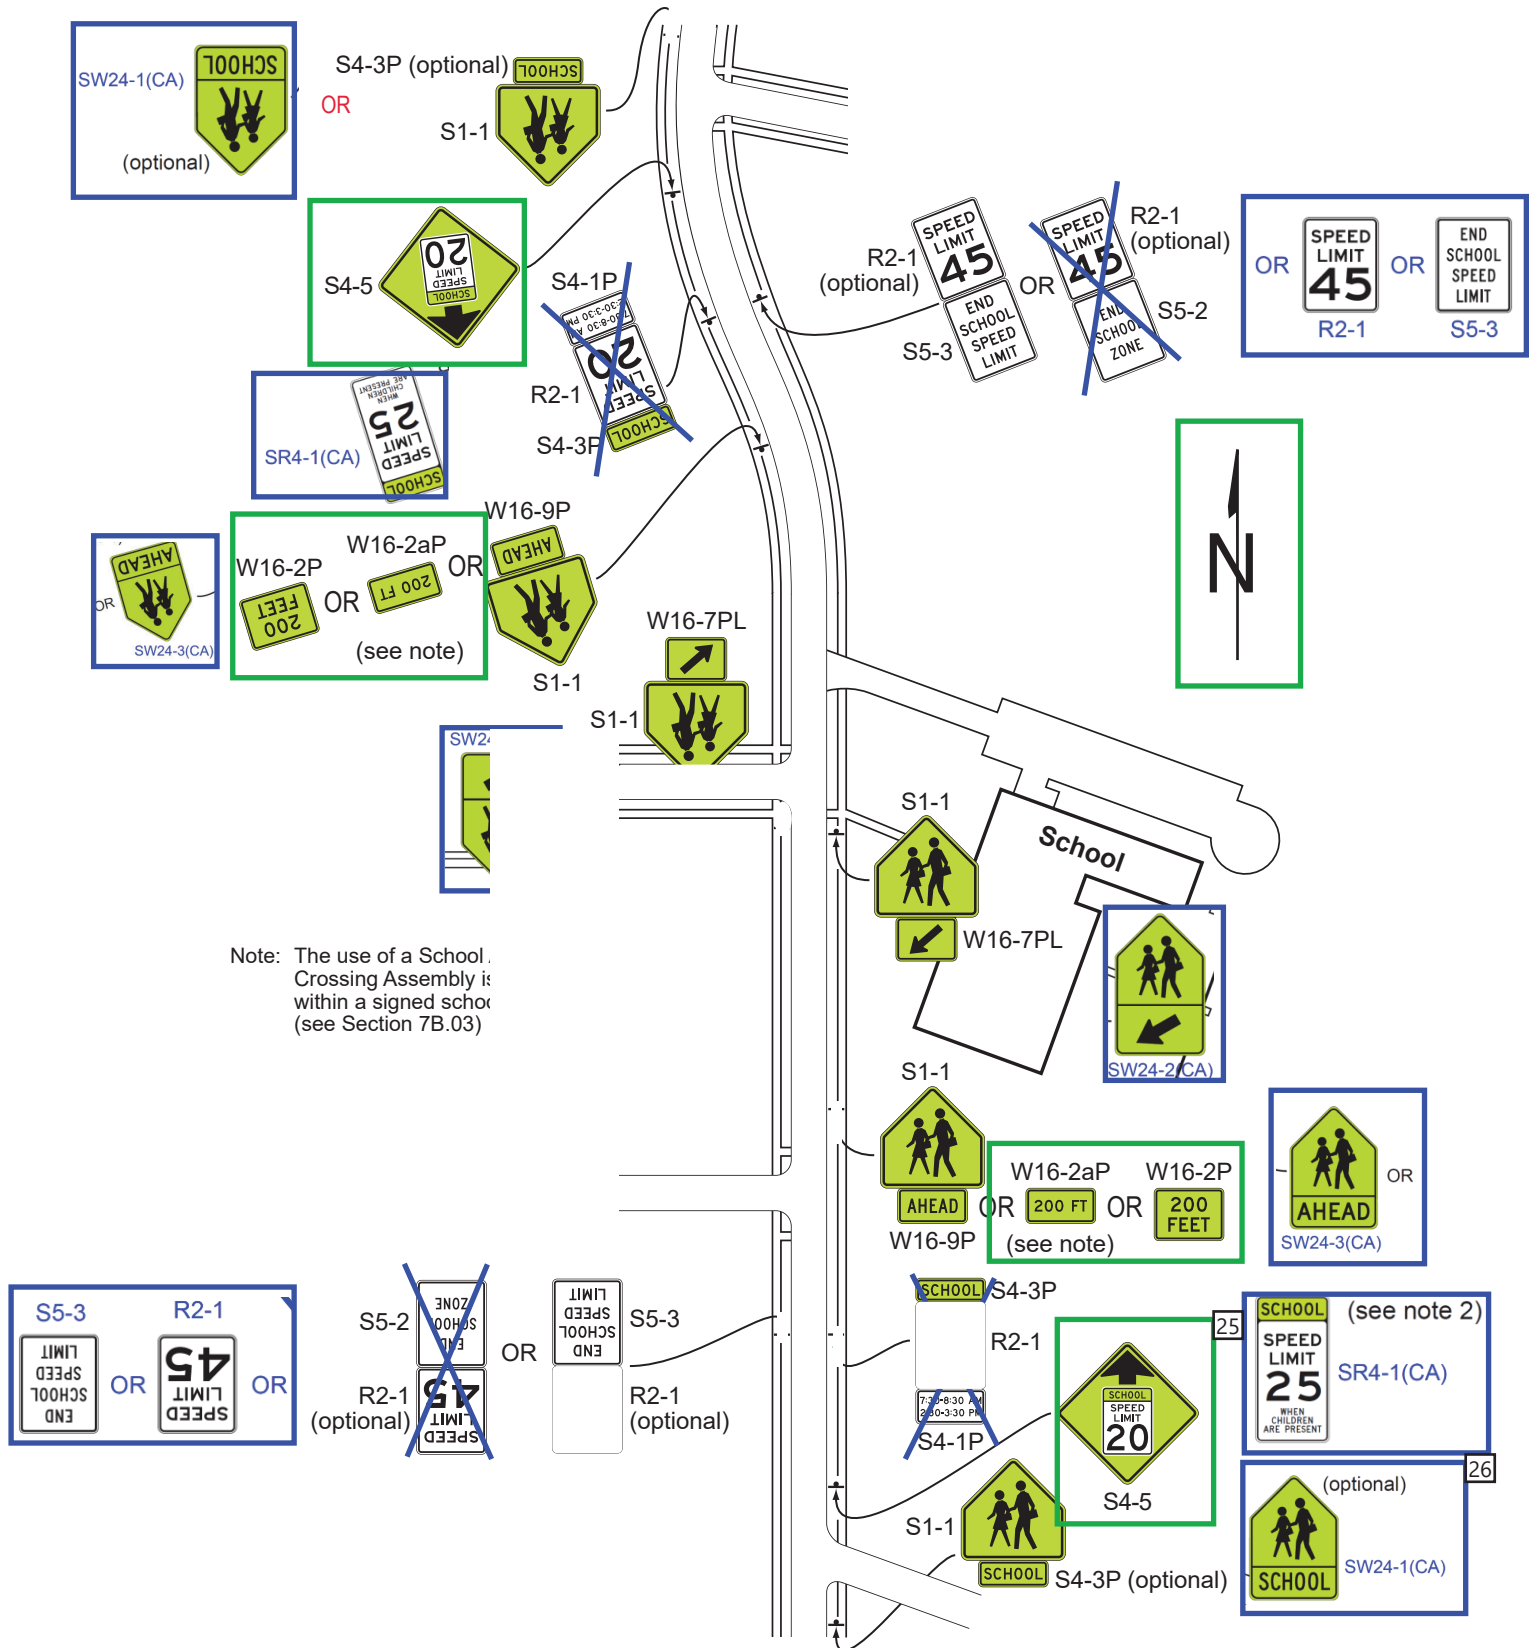

Incorporated from CA MUTCD 2014R8 Figure 7B-5

☐ Number: 25 Author: s116730 Subject: Rectangle Date: 7/13/2024 10:10:35 AM  
NMUTCD 2023 added new sign

---

☐ Number: 26 Author: s116730 Subject: Rectangle Date: 7/10/2024 9:56:45 AM  
Incorporated from CA MUTCD 2014R8 Figure 7B-5

---









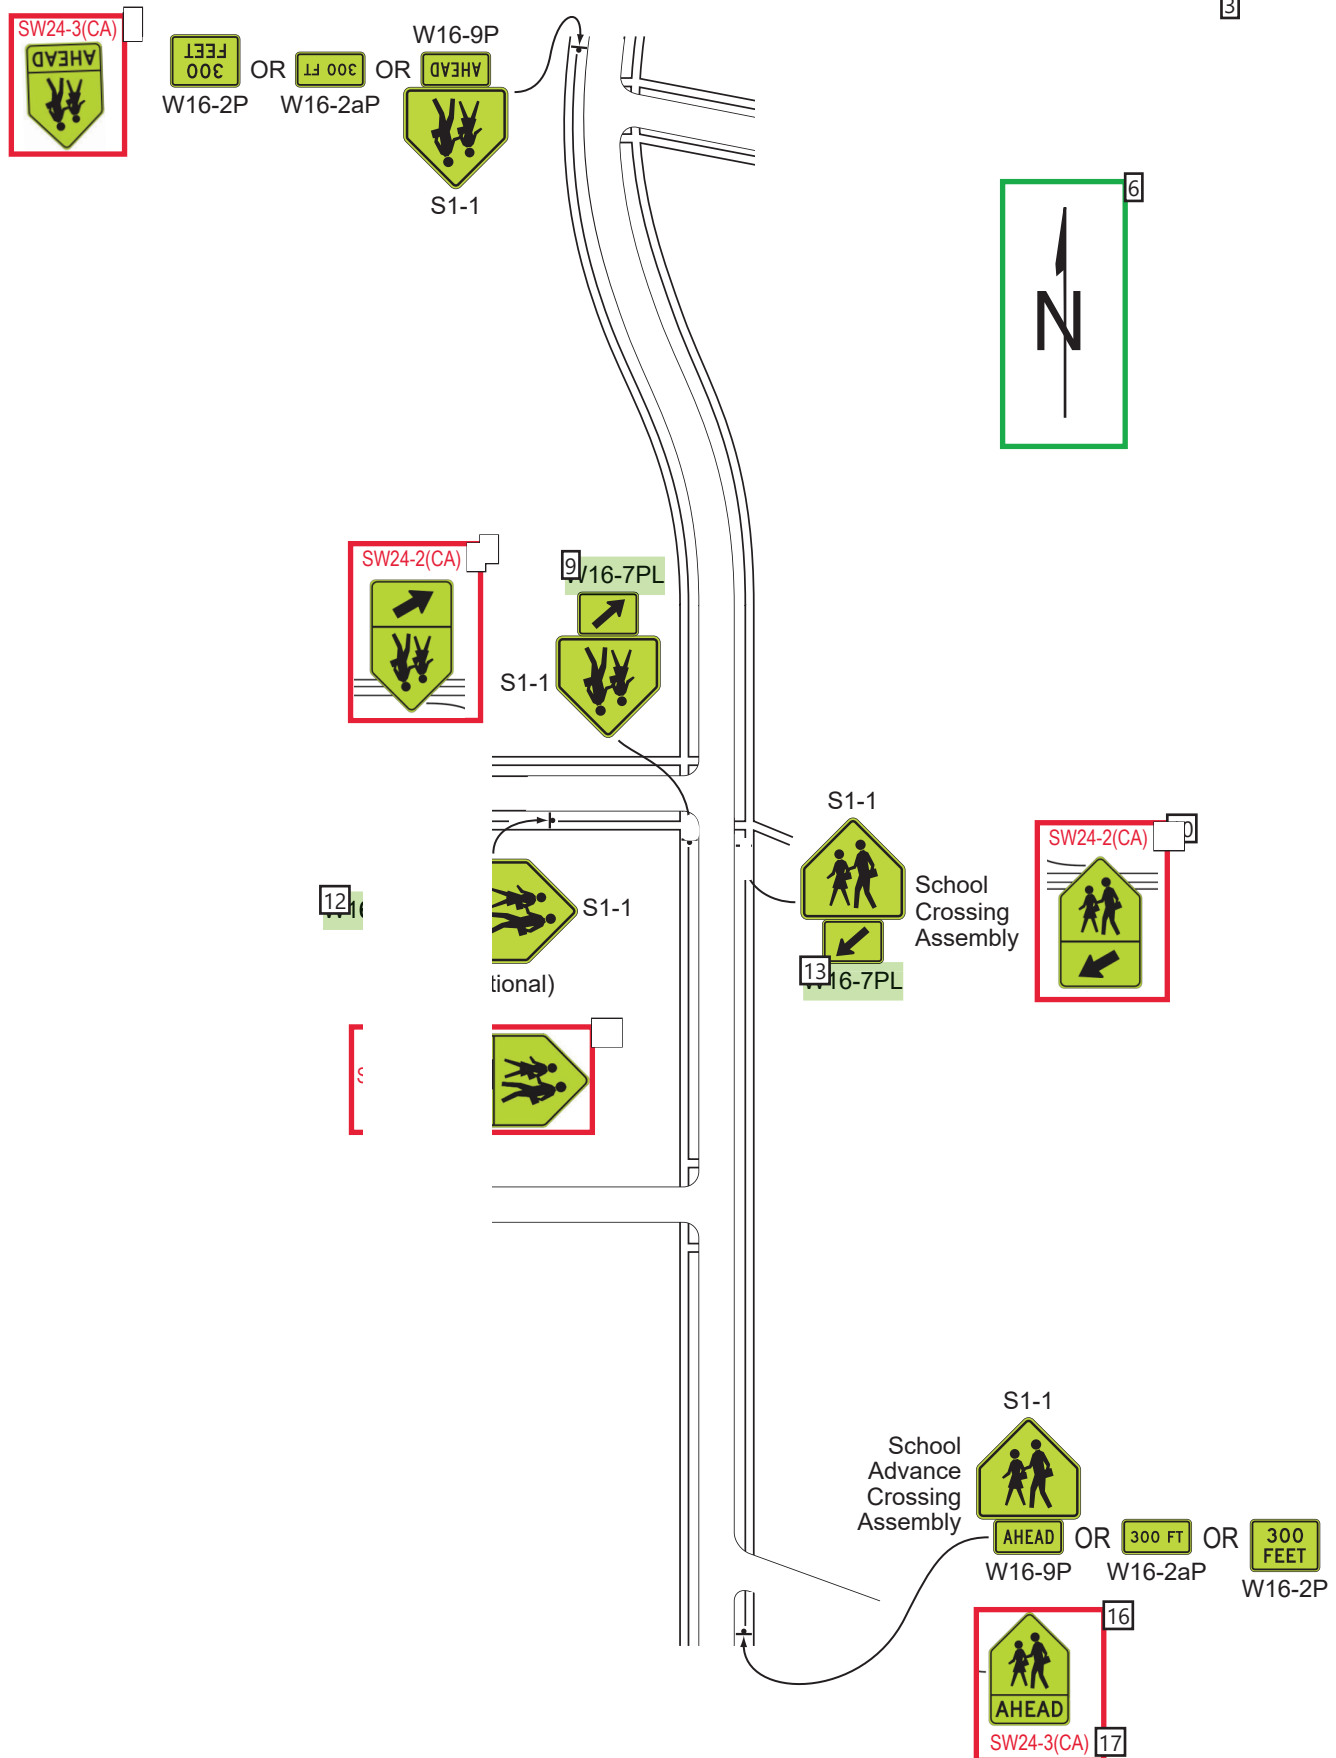



Figure 7B-2(CA) Example of Signing for a School Zone with a School Speed Limit and a School Crossing

	Number: 1	Author: s116730	Subject: Rectangle	Date: 7/10/2024 3:54:08 PM
	Number: 2	Author: s116730	Subject: Rectangle	Date: 7/10/2024 3:56:44 PM
	Add new note: 3. See Section 7B.02 for Assembly A(CA), Section 7B.03 for Assemblies B(CA), D(CA) and E(CA), and Section 7B.05 for Assembly C.			
	Number: 3	Author: s116730	Subject: Text Box	Date: 7/10/2024 3:39:15 PM
			7B-2(CA)	
	Number: 4	Author: s116730	Subject: Line	Date: 7/10/2024 3:52:15 PM
	NMUTCD 2023 changed NMUTCD 2009 Figure 7B-5 to 7B-2. This figure is renumbered as 7B-2(CA) and is included in CA MUTCD 2026			
	Number: 5	Author: s116730	Subject: Highlight	Date: 7/25/2024 9:49:13 AM
	NMUTCD 2023 changed NMUTCD 2009 Figure 7B-5 to 7B-2. This figure is renumbered as 7B-2(CA) and is included in CA MUTCD 2026			

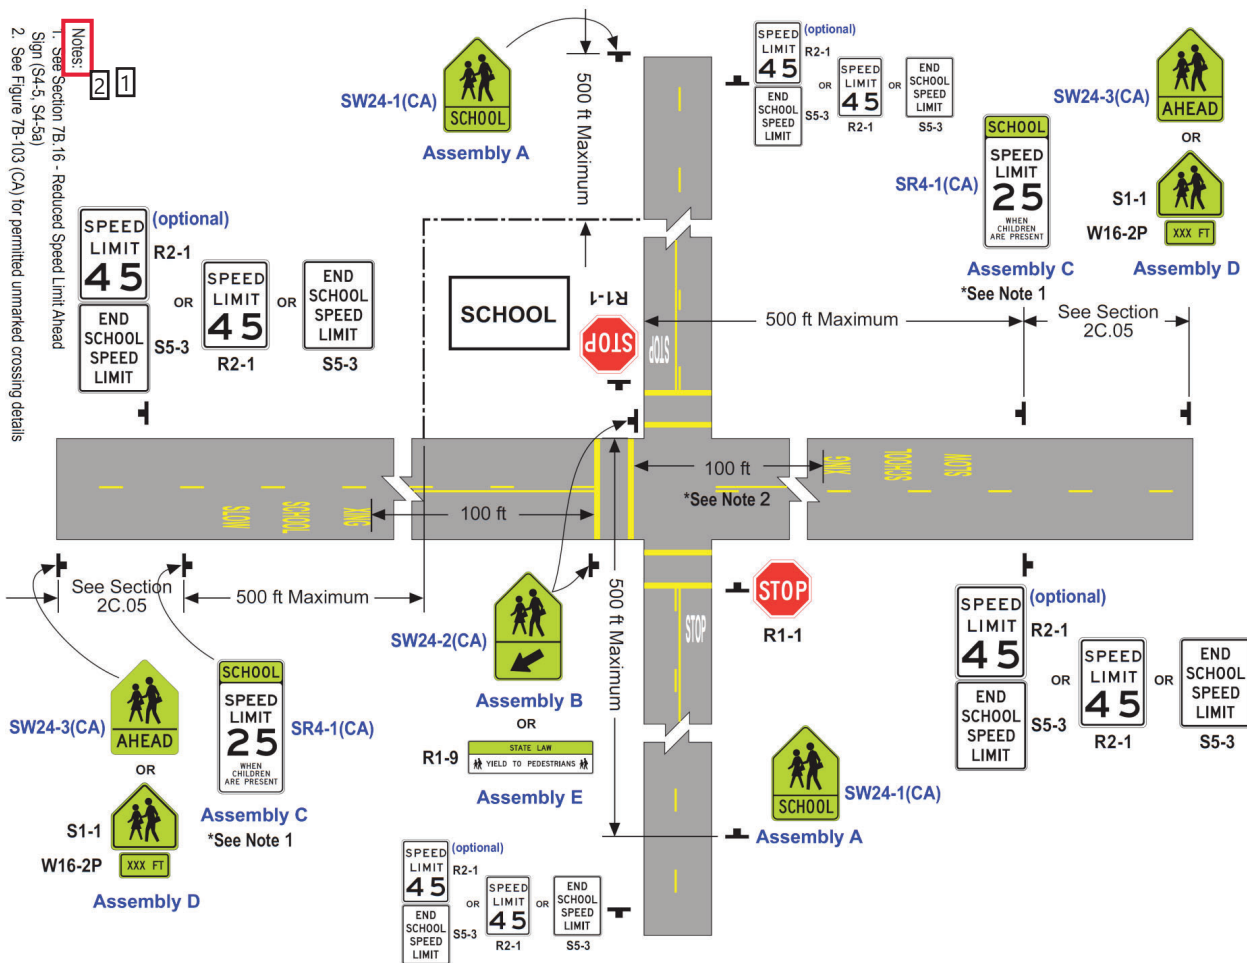
**Figure B-3. Example of Signing for a School Crossing Outside of a School Zone**





## Page: 6


 Number: 1 Author: s116730 Subject: Highlight Date: 7/25/2024 9:49:29 AM  
Options for CA signs that are combined with plaques (for all signs shown on this sheet) will be added


NMUTCD 2023 added sign codes for all signs, which were missing in NMUTCD 2009 figures


 Number: 2 Author: s116730 Subject: Highlight Date: 7/25/2024 9:49:32 AM  
NMUTCD 2023 changed NMUTCD 2009 Figure 7B-4 to 7B-3 and added sign codes for the signs shown in the figure.


 Number: 3 Author: s116730 Subject: Text Box Date: 7/10/2024 3:11:55 PM


 Number: 4 Author: s116730 Subject: Rectangle Date: 7/10/2024 3:20:12 PM  
Add SW24-3(CA) Assembly D(CA) image


 Number: 5 Author: s116730 Subject: Text Box Date: 7/10/2024 2:56:21 PM  
SW24-3(CA)


 Number: 6 Author: s116730 Subject: Rectangle Date: 7/14/2024 8:41:23 AM  
NMUTCD 2023 added new cardinal direction "N" arrow


 Number: 7 Author: s116730 Subject: Rectangle Date: 7/10/2024 3:21:59 PM  
Add SW24-2(CA) Assembly B(CA) image


 Number: 8 Author: s116730 Subject: Text Box Date: 7/10/2024 2:59:39 PM  
SW24-2(CA)


 Number: 9 Author: s116730 Subject: Highlight Date: 7/25/2024 9:49:59 AM  
NMUTCD 2023 changed the NMUTCD 2009 sign code "W16-7P" to "W16-7PL"


 Number: 10 Author: s116730 Subject: Rectangle Date: 7/10/2024 3:21:47 PM  
Add SW24-2(CA) Assembly B(CA) image


 Number: 11 Author: s116730 Subject: Text Box Date: 7/10/2024 3:00:31 PM  
SW24-2(CA)


 Number: 12 Author: s116730 Subject: Highlight Date: 7/25/2024 9:50:05 AM  
NMUTCD 2023 changed the NMUTCD 2009 sign code "W16-6P" to "W16-6PR"

 Number: 13 Author: s116730 Subject: Highlight Date: 7/25/2024 9:50:09 AM  
NMUTCD 2023 changed the NMUTCD 2009 sign code "W16-7P" to "W16-7PL"


 Number: 14 Author: s116730 Subject: Rectangle Date: 7/10/2024 3:23:06 PM  
Add SW24-1(CA) Assembly A(CA) image

 Number: 15 Author: s116730 Subject: Text Box Date: 7/10/2024 3:05:01 PM  
SW24-1(CA)

 Number: 16 Author: s116730 Subject: Rectangle Date: 7/10/2024 3:22:25 PM  
Add SW24-3(CA) Assembly D(CA) image

 Number: 17 Author: s116730 Subject: Text Box Date: 7/10/2024 3:08:39 PM  
SW24-3(CA)

**Figure 7B-4. Example of Signing for a School Zone with a School Speed Limit and Higher Fines Only for Speeding**

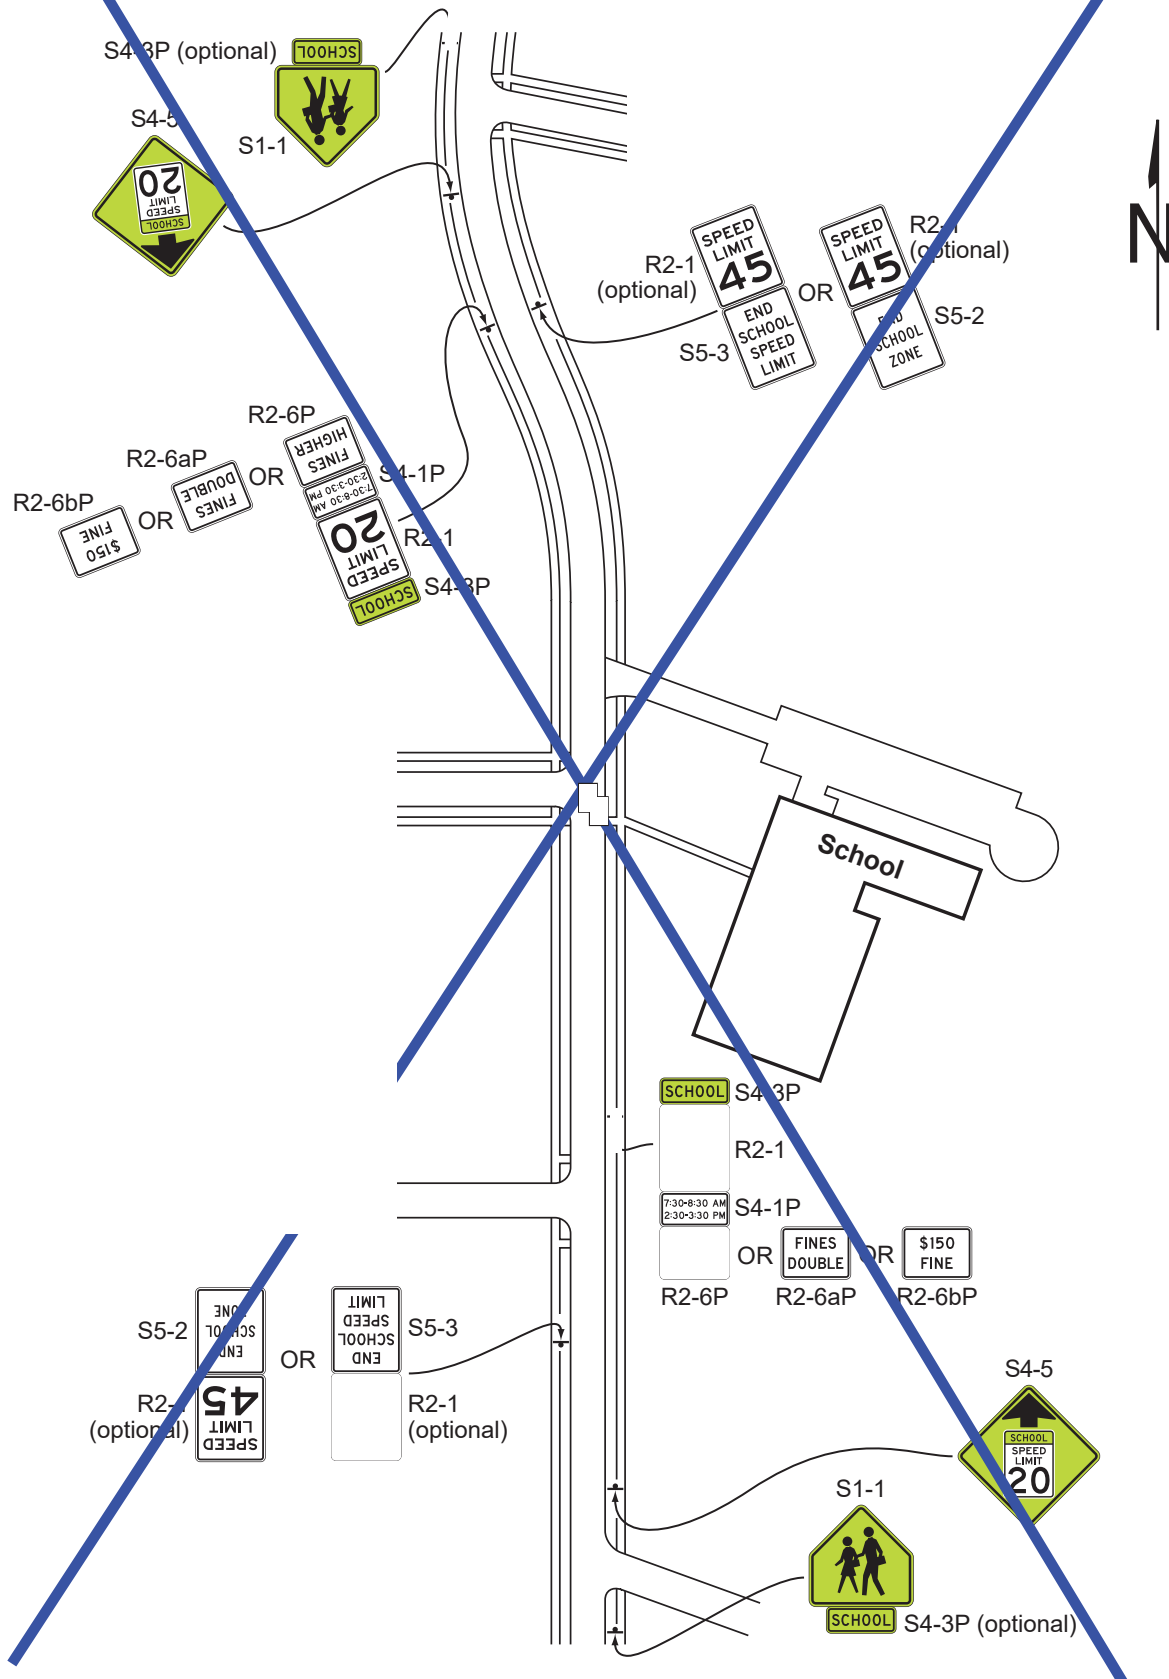


---

Number: 1      Author: s116730      Subject: Line      Date: 7/10/2024 3:16:43 PM

---

Number: 2      Author: s116730      Subject: Line      Date: 7/10/2024 3:16:27 PM


---

 Number: 3      Author: s116730      Subject: Highlight      Date: 7/25/2024 9:50:21 AM  
NMUTCD 2023 changed NMUTCD 2009 Figure number 7B-3 to 7B-4 and made other minor changes in the figure. This figure was shown in CA MUTCD 2014R8 with a blue "X".NMUTCD 2023 Figure 7B-4 is shown in CA MUTCD 2026 with a blue "X"

Since this figure is not applicable in CA, specific changes made in NMUTCD 2023 have not been identified.

### Figure 7B-5. Example of Signing for a School Zone with Higher Fines for All Traffic Violations (Sheet 1 of 2)

A – Higher fines zone begins at the beginning of the school zone

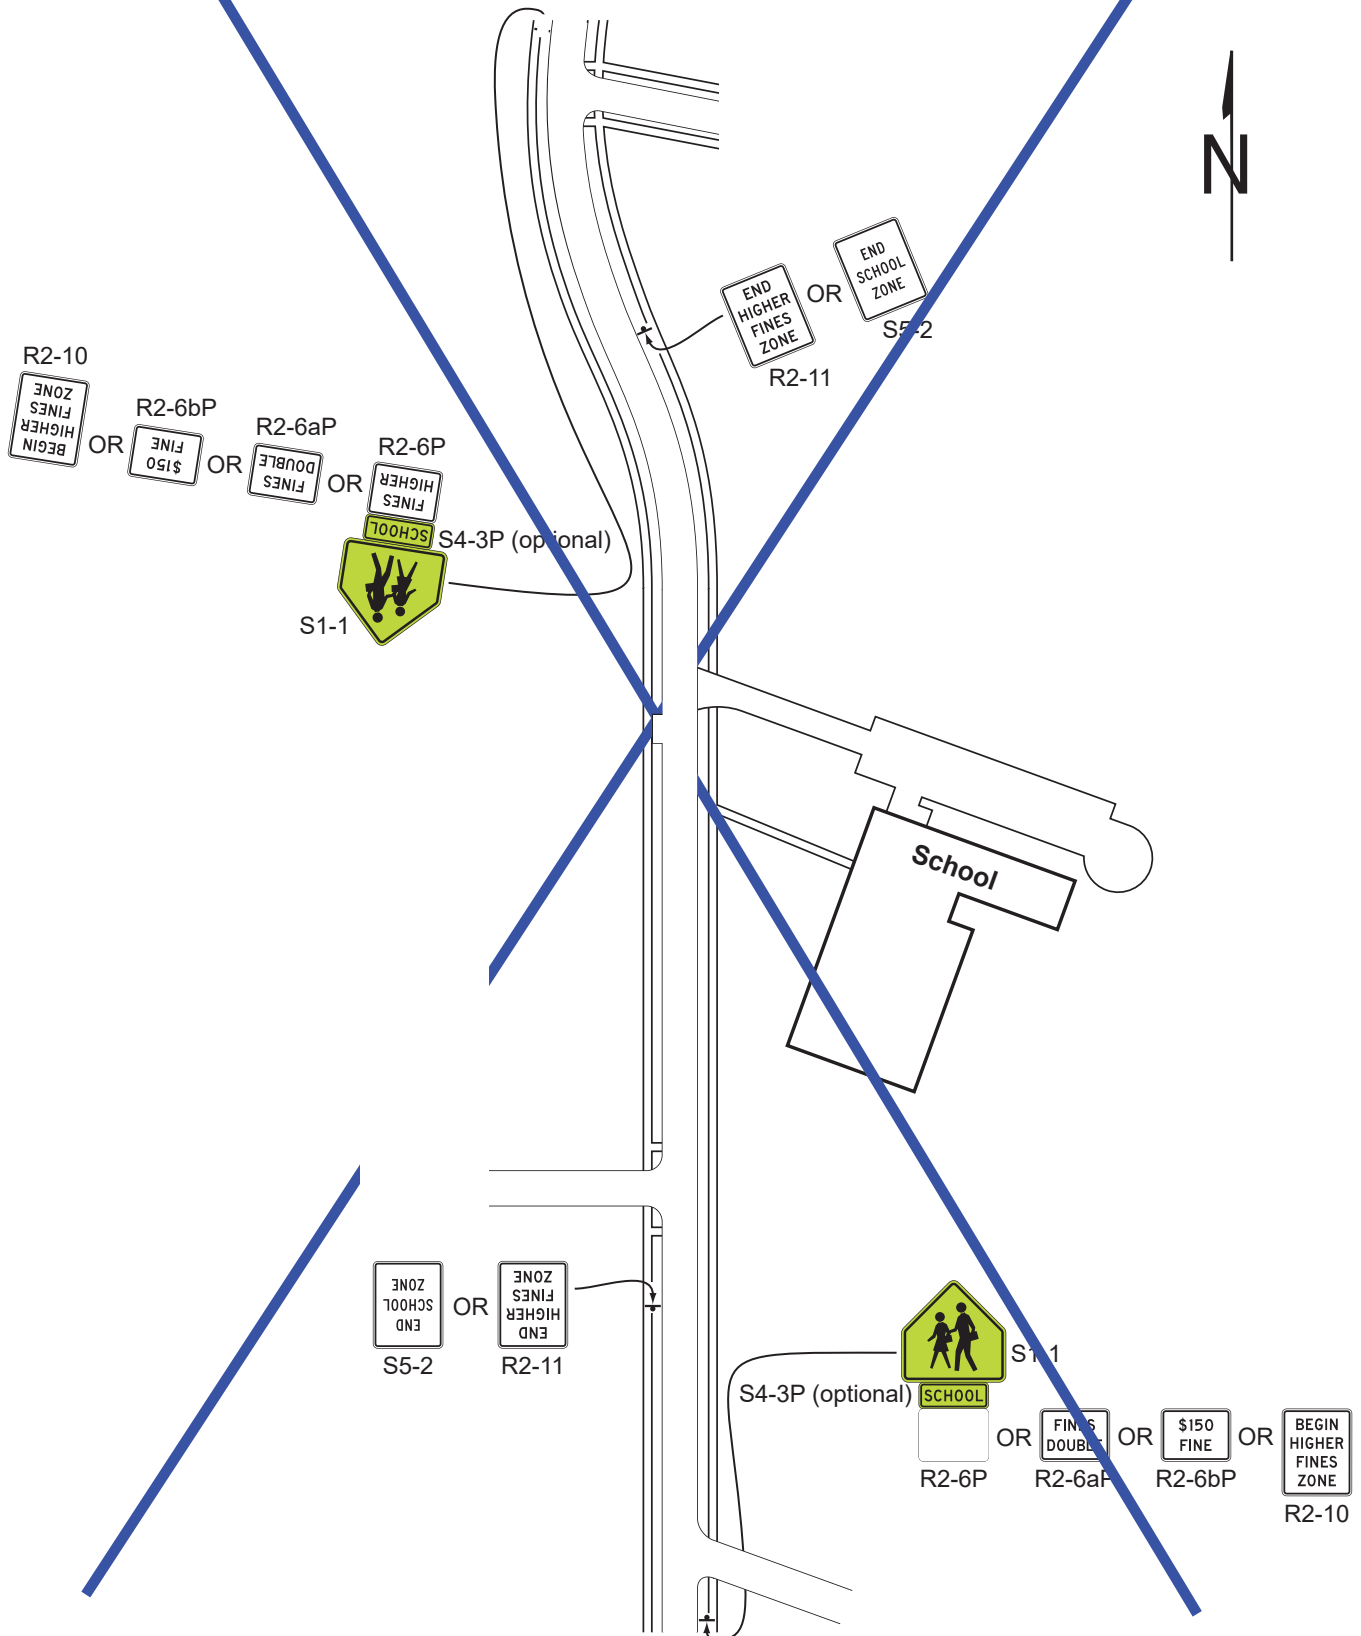


---

Number: 1      Author: s116730      Subject: Line      Date: 7/10/2024 3:17:16 PM

---

Number: 2      Author: s116730      Subject: Line      Date: 7/10/2024 3:17:16 PM

---

 Number: 3      Author: s116730      Subject: Highlight      Date: 7/25/2024 9:50:27 AM

---


NMUTCD 2023 changed NMUTCD 2009 Figure number 7B-2 to 7B-5 (Sheets 1 and 2 of 2) and made other minor changes in the figure.  
NMUTCD 2023 Figure 7B-5(Sheet 1 of 2) is shown in CA MUTCD 2026 with a blue "X"

Since this figure is not applicable in CA, specific changes made in NMUTCD 2023 have not been identified.



**Figure 7B-5. Example of Signing for a School Zone with Higher Fines for All Traffic Violations (Sheet 2 of 2)**

**B – Higher fines zone begins after the beginning of the school zone**

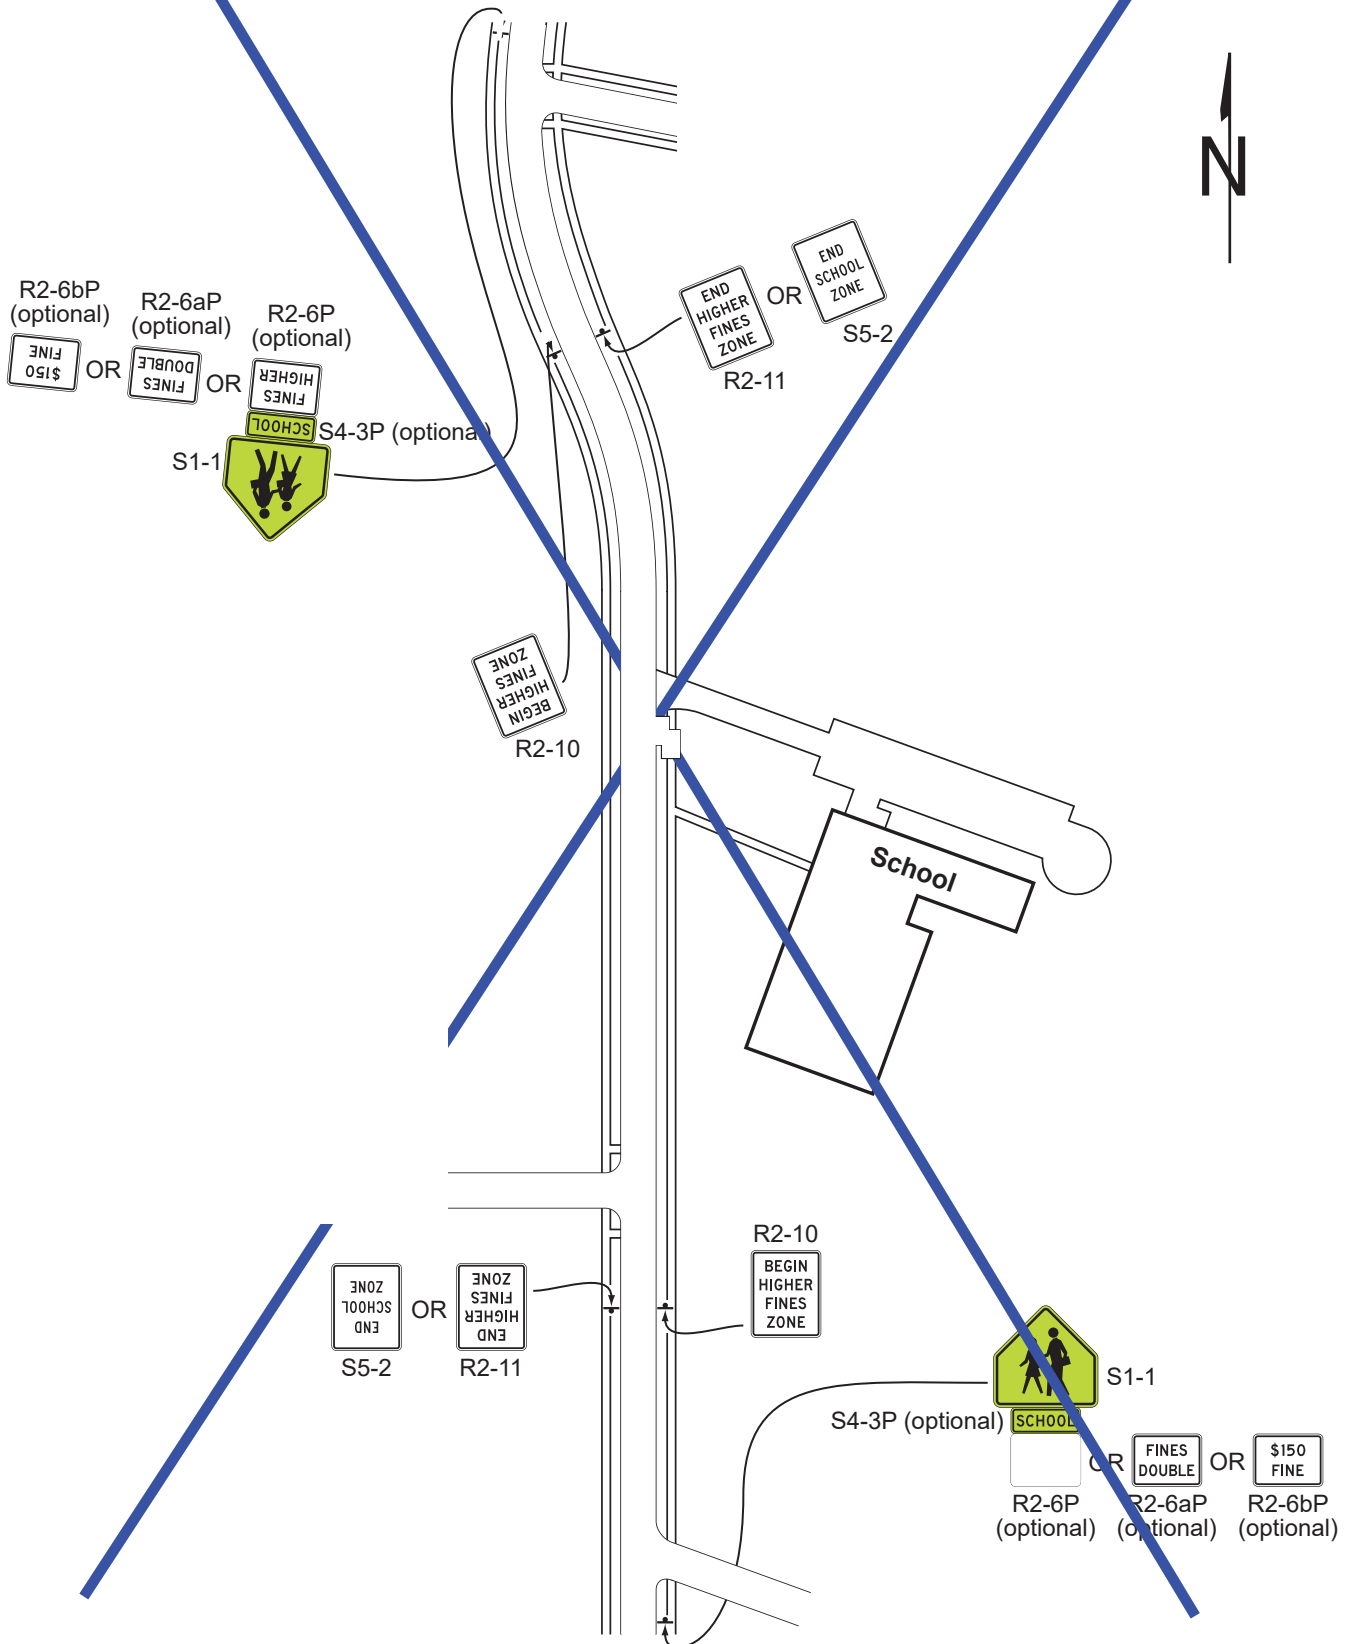


---

Number: 1      Author: s116730      Subject: Line      Date: 7/10/2024 3:17:19 PM

---

Number: 2      Author: s116730      Subject: Line      Date: 7/10/2024 3:17:19 PM

---


 Number: 3      Author: s116730      Subject: Highlight      Date: 7/25/2024 9:50:31 AM

---


NMUTCD 2023 changed NMUTCD 2009 Figure number 7B-2 to 7B-5 (Sheet 1 and 2 of 2) and made other minor changes in the figure.  
NMUTCD 2023 Figure 7B-5(Sheet 2 of 2) is shown in CA MUTCD 2026 with a blue "X"

Since this figure is not applicable in CA, specific changes made in NMUTCD 2023 have not been identified.

Figure 7B-101 (CA). Example of School Area Signs with Flashing Yellow Beacons

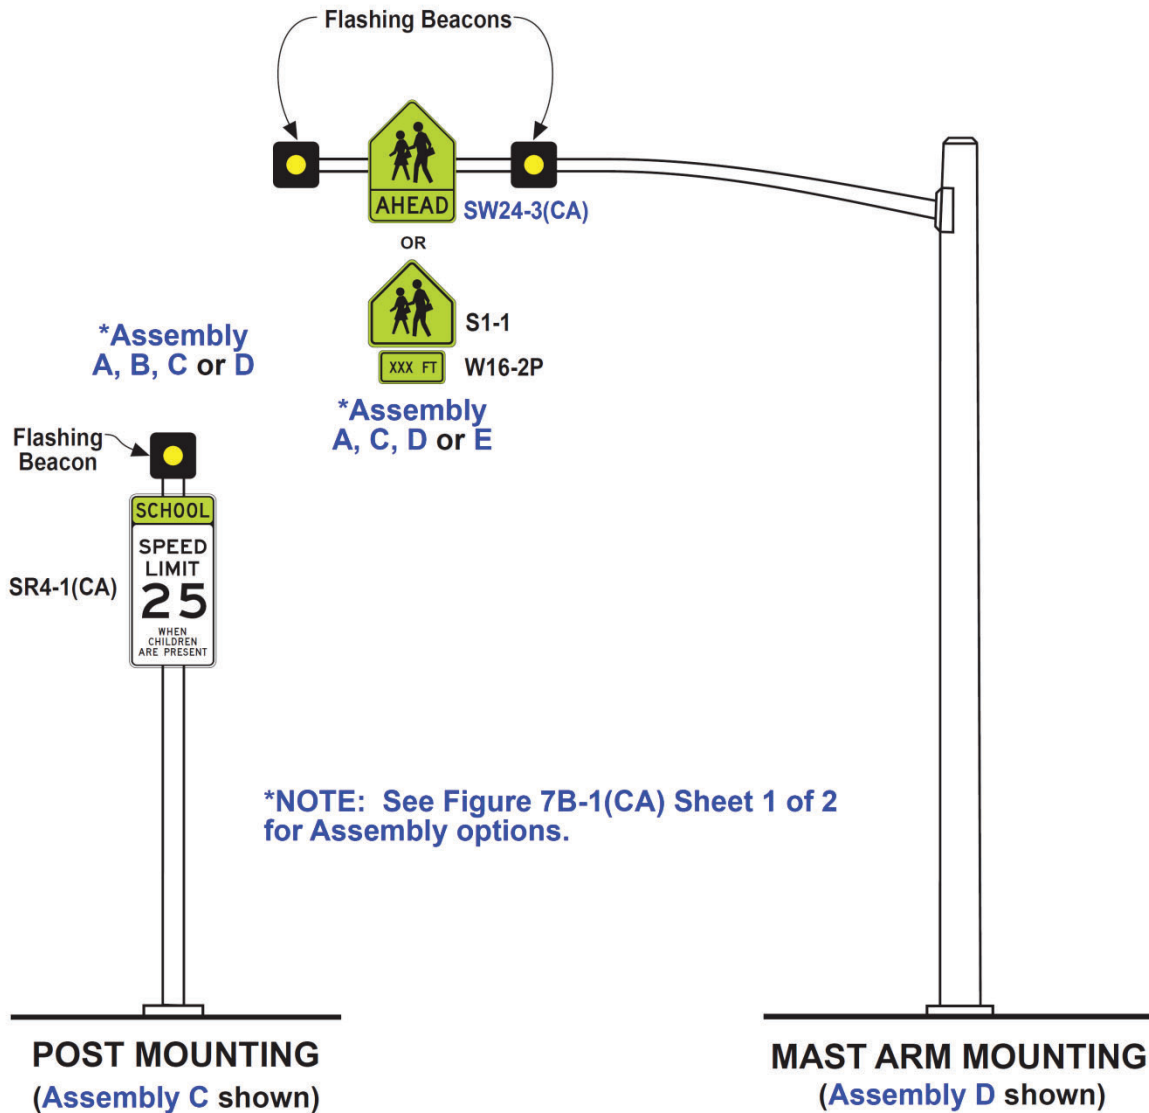




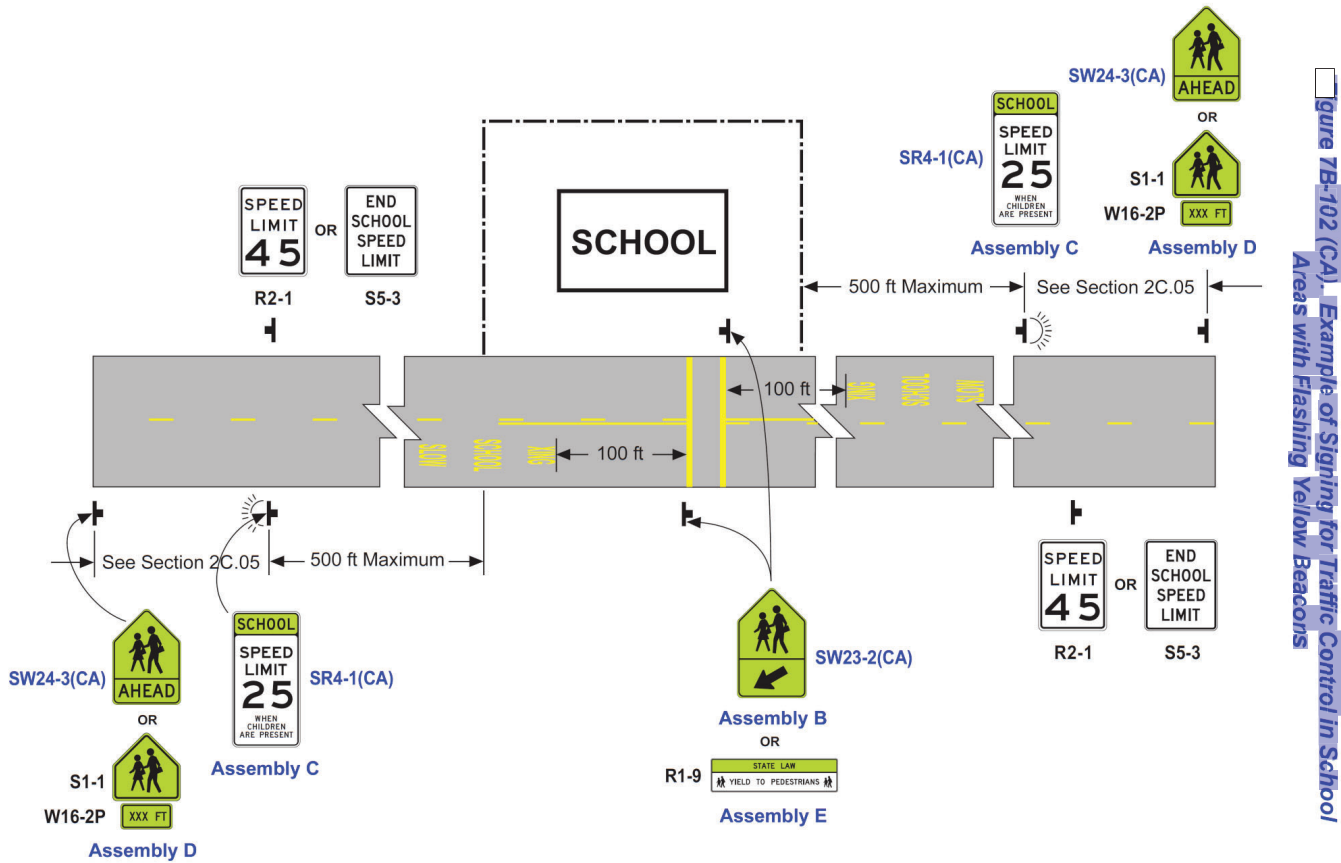



**Figure 7B-103(CA). Example of Signing for School Area Traffic Control with Extended and/or Reduced School Zone Speed Limits**

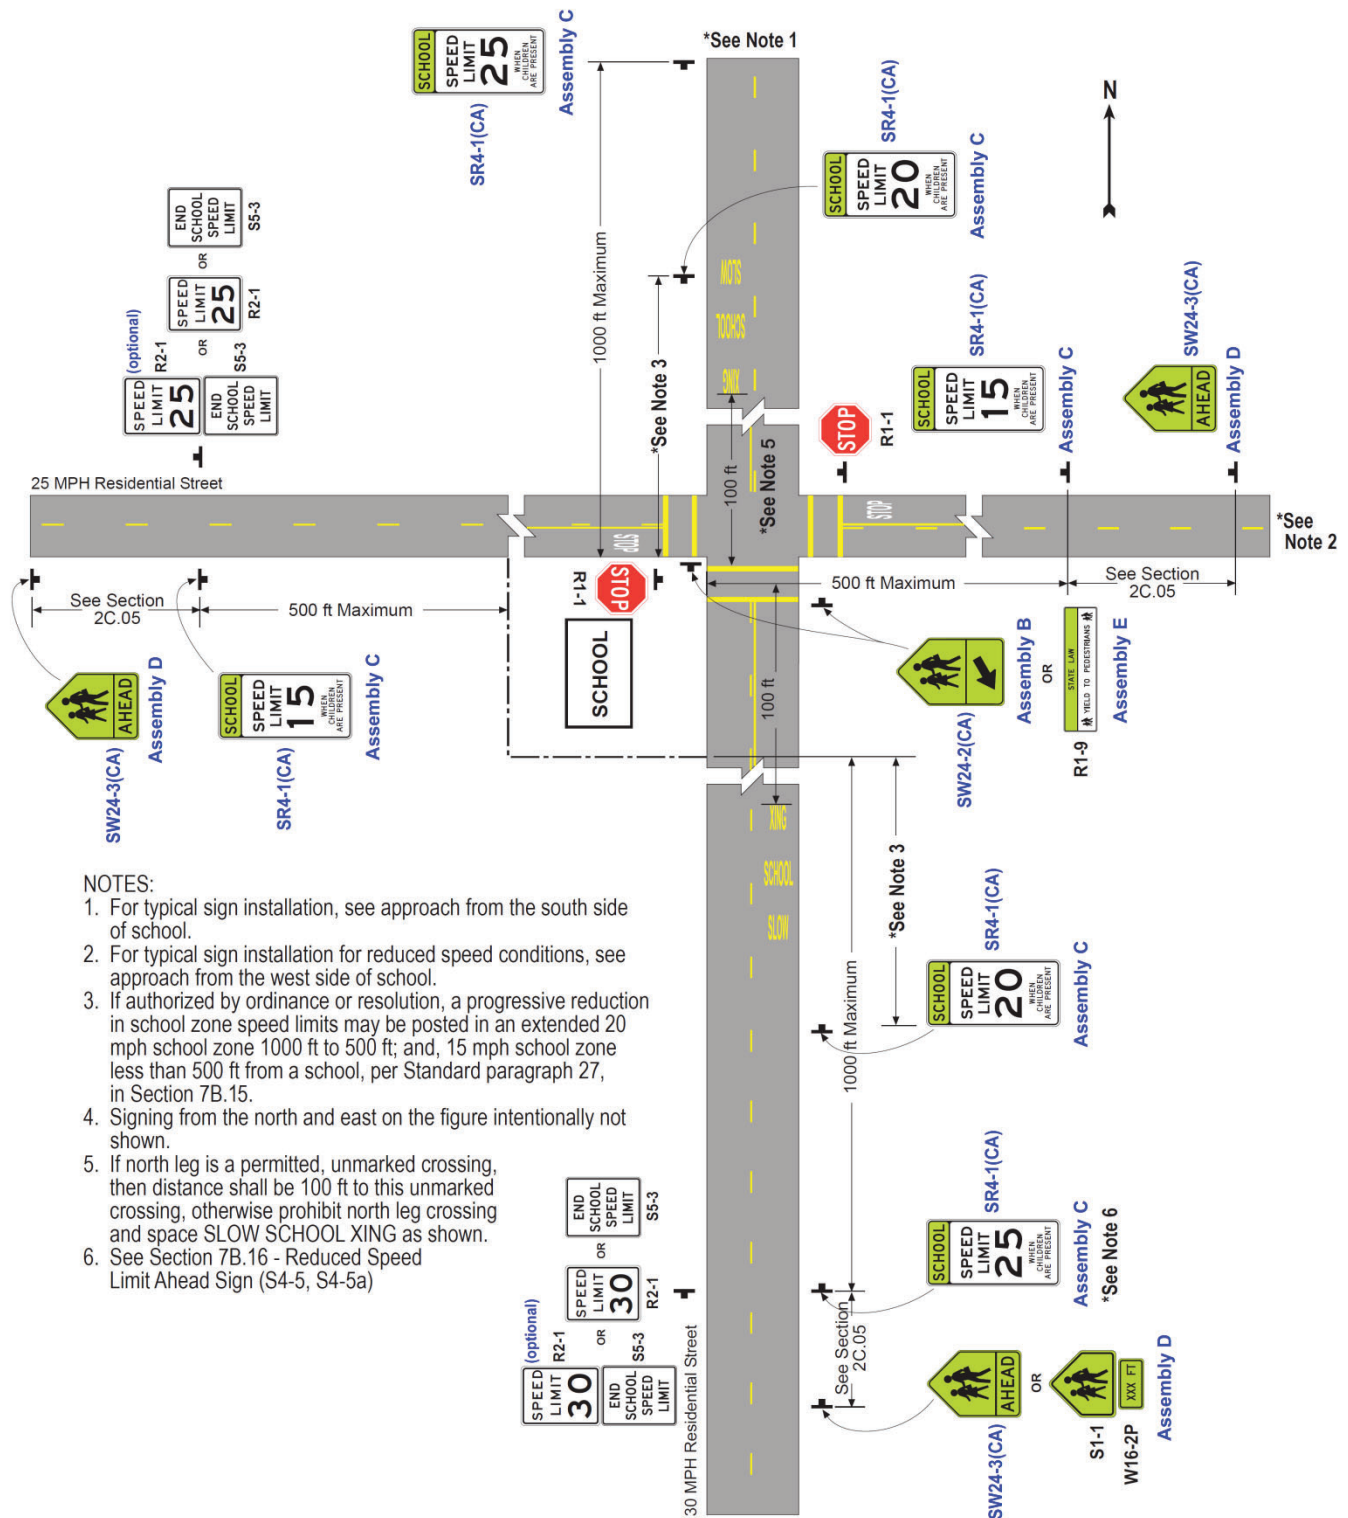

- NOTES:
1. For typical sign installation, see approach from the south side of school.
  2. For typical sign installation for reduced speed conditions, see approach from the west side of school.
  3. If authorized by ordinance or resolution, a progressive reduction in school zone speed limits may be posted in an extended 20 mph school zone 1000 ft to 500 ft; and, 15 mph school zone less than 500 ft from a school, per Standard paragraph 27, in Section 7B.15.
  4. Signing from the north and east on the figure intentionally not shown.
  5. If north leg is a permitted, unmarked crossing, then distance shall be 100 ft to this unmarked crossing, otherwise prohibit north leg crossing and space SLOW SCHOOL XING as shown.
  6. See Section 7B.16 - Reduced Speed Limit Ahead Sign (S4-5, S4-5a)





Figure 7B-104(CA). Example of Signing for School Crosswalk Warning Assembly

