DIST. NO.	STATE	FED. RD. NO.	YEAR	SHEET NO.	TOTAL SHEETS
2	CAL.	177-B	1930	3	11
DIV.	COUNTY	ROUTE	SEC.	SHEET NO.	TOTAL SHEETS
VI	Mad.	4	FC	3	14

Approved April 8 1929

State Highway Engineer

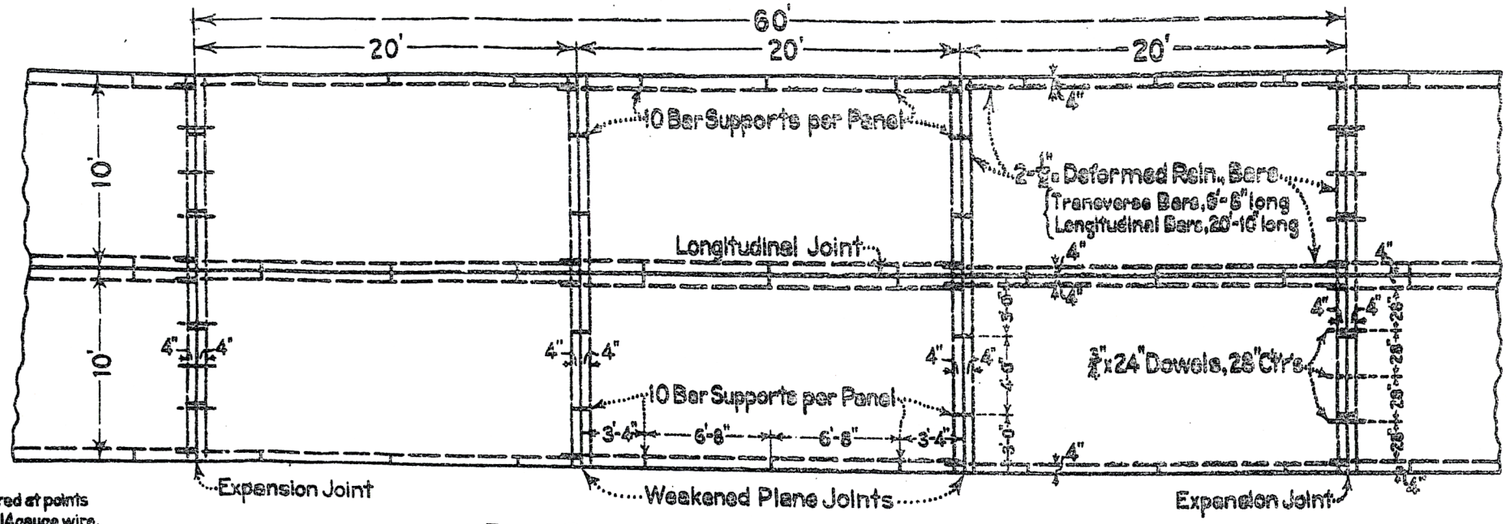

Note: All bars to be wired at points of contact with 14 gauge wire.

PLAN SHOWING TWO TYPICAL 10 FOOT STRIPS
SCALE: ¼"=1'

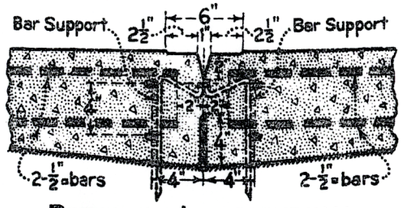

DETAIL OF LONGITUDINAL WEAKENED PLANE
To be placed in pavement with thickened center laid full width.
SCALE: 2"=1'

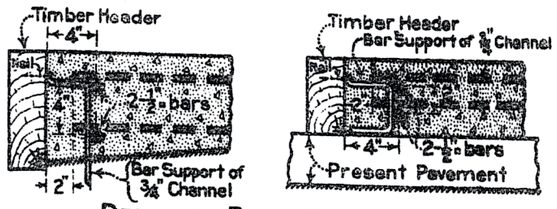

DETAIL OF EDGE REINFORCEMENT
SCALE: 2"=1'

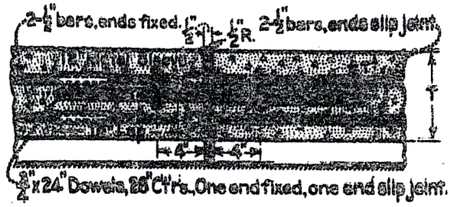

DETAIL OF TRANSVERSE EXPANSION JOINT
To be placed at 80 foot intervals.
SCALE: 2"=1'

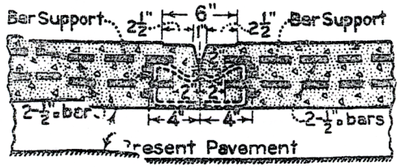

DETAIL OF LONGITUDINAL WEAKENED PLANE
To be placed in Second Story Pavement.
SCALE: 2"=1'

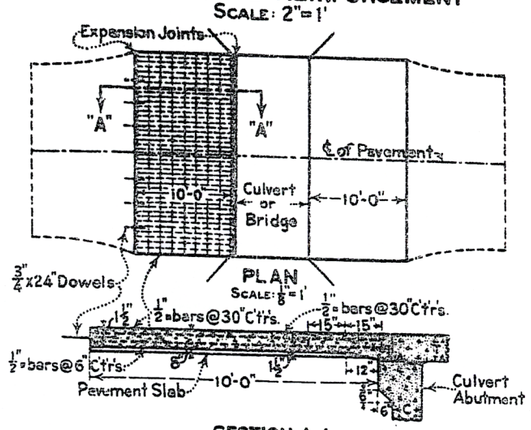

PLAN
SCALE: ⅛"=1'

SECTION A-A
SCALE: ⅜"=1'

DETAILS OF PAVEMENT REINFORCEMENT AT CULVERT APPROACHES

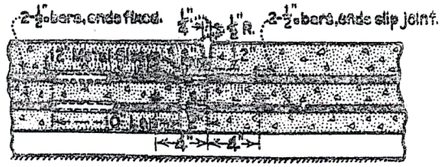

DETAIL OF TRANSVERSE WEAKENED PLANE
To be placed at 20 foot intervals between expansion joints.
SCALE: 2"=1'

STATE OF CALIFORNIA
DEPARTMENT OF PUBLIC WORKS
DIVISION OF HIGHWAYS

PAVING DETAILS

April 6, 1929

AS BUILT PLANS